


Give All Information Completely
Make Required Affidavit
Mail or Deliver Report to:
Conservation Division
State Corporation Commission
212 No. Market
Wichita, Kansas

WELL PLUGGING RECORD

NORTH

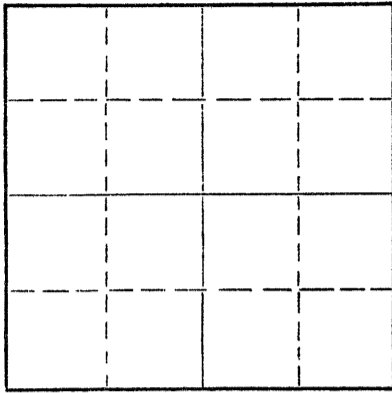

Locate well correctly on above
Section Plat

Decatur County. Sec. 14 Twp. 1S Rge. 29 (E) W (W)
Location as "NE/CNW/SW" or footage from lines NW SW
Lease Owner Norman D. Fitzgerald
Lease Name Slim Macy Well No. 1
Office Address P. O. Box 5046, Abilene, Texas 79605
Character of Well (completed as Oil, Gas or Dry Hole) D & A
Date well completed October 26, 1968
Application for plugging filed October 26, 1968
Application for plugging approved October 26, 1968
Plugging commenced October 26, 1968
Plugging completed October 26, 1968
Reason for abandonment of well or producing formation D & A

If a producing well is abandoned, date of last production _____ 19____
Was permission obtained from the Conservation Division or its agents before plugging was commenced? Yes

Name of Conservation Agent who supervised plugging of this well W. L. Nichols
Producing formation _____ Depth to top _____ Bottom _____ Total Depth of Well 2815 Feet
Show depth and thickness of all water, oil and gas formations.

OIL, GAS OR WATER RECORDS

CASING RECORD

FORMATION	CONTENT	FROM	TO	SIZE	PUT IN	PULLED OUT
				8 5/8"	242.12'	-0-

Describe in detail the manner in which the well was plugged, indicating where the mud fluid was placed and the method or methods used in introducing it into the hole. If cement or other plugs were used, state the character of same and depth placed, from _____ feet to _____ feet for each plug set.

#1 set plug @ 1400'
25 sx HA-5. #2 set plug
@ 1150', 100 sx. 50/50
poz 6% gel. #3 plug set
@ 249', 20 sx, 6 sx hulls,
6% gel, set plug @ 40',
10 sx 6% gel. Hole plugged
@ 7:00 A.M. 5 sx. in
rathole.

RECEIVED
STATE CORPORATION COMMISSION
NOV 8 1968
CONSERVATION DIVISION
Wichita, Kansas

11-8-1968

(If additional description is necessary, use BACK of this sheet)

Name of Plugging Contractor Red Tiger Drilling Company
Address 1720 Wichita Plaza Building, Wichita, Kansas 67202

STATE OF Kansas, COUNTY OF Sedgwick, ss.
Norman E. Klein (employee of owner) or (owner or operator) of the above-described well, being first duly sworn on oath, says: That I have knowledge of the facts, statements, and matters herein contained and the log of the above-described well as filed and that the same are true and correct. So help me God.

(Signature) Norman E. Klein
1720 Wichita Plaza, Wichita, Kansas
(Address)

SUBSCRIBED AND SWORN TO before me this 5th day of November, 1968

Donald A. Hove

My commission expires My Commission Expires Aug. 27, 1969

Notary Public.

15-039-20063-00-00

DRILLERS LOG

No. 1 Slim Macy

CASING RECORD:	COMPANY:	Norman D. Fitzgerald	DESCRIPTION:
8 5/8" @ 249'	CONTRACTOR:	Red Tiger Drilling Co.	NW SW
w/190 sx cement	COMMENCED:	October 19, 1968	14-1S-29W
	COMPLETED:	October 26, 1968	Decatur County, Kansas
TOTAL DEPTH: 2815:			ELEVATION:

<u>FORMATION</u>	<u>FROM</u>	<u>TO</u>	<u>REMARKS</u>
Shale	0	89	
Sand	89	210	
Shale	210	300	
Shale with sand streaks	300	1370	
Shale with sand and shells	1370	1855	
Shale and shells	1855	2154	
Shale	2154	2389	
Anhydrite	2389	2419	
Shale and shells	2419	2815	

RECEIVED
STATE CORPORATION COMMISSION
NOV 8 1968
CONSERVATION DIVISION
Wichita, Kansas
11-8-1968

I certify that this is a true and correct copy of the above log to the best of my knowledge.

RED TIGER DRILLING COMPANY


Norman E. Klein

Subscribed and sworn to before me this 5th day of November, 1968.


Notary Public

My Commission Expires:
My Commission Expires Aug. 27, 1969