

15-039-2019600-00

STATE OF KANSAS
STATE CORPORATION COMMISSION

Form CP-4


Give All Information Completely
Make Required Affidavit
Mail or Deliver Report to:
Conservation Division
State Corporation Commission
212 No. Market
Wichita, Kansas 67202

WELL PLUGGING RECORD

Decatur County, Sec. 32 Twp. 1S Rge. (E) 29 (W)

Location as "NE/CNW%SW%" or footage from lines C NE SW
Lease Owner Rosen Oil Corporation
Lease Name Templeton "B" Well No. 1
Office Address 200 Sutton Place, Wichita, Kansas
Character of Well (completed as Oil, Gas or Dry Hole) Dry Hole
Date well completed November 16, 1970
Application for plugging filed 19
Application for plugging approved 19
Plugging commenced November 16, 1970
Plugging completed November 16, 1970
Reason for abandonment of well or producing formation Dry Hole

NORTH

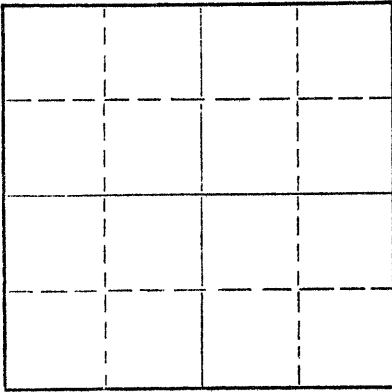

Locate well correctly on above
Section Plat

If a producing well is abandoned, date of last production 19
Was permission obtained from the Conservation Division or its agents before plugging was commenced? Yes

Name of Conservation Agent who supervised plugging of this well W. L. Nichols, Morland, Kansas
Producing formation Depth to top Bottom Total Depth of Well 3940 Feet
Show depth and thickness of all water, oil and gas formations.

OIL, GAS OR WATER RECORDS

CASING RECORD

FORMATION	CONTENT	FROM	TO	SIZE	PUT IN	PULLED OUT
	Surface	0	230'	8-5/8"	230'	-----
	Casing					

Describe in detail the manner in which the well was plugged, indicating where the mud fluid was placed and the method or methods used in introducing it into the hole. If cement or other plugs were used, state the character of same and depth placed, from feet to feet for each plug set.

Heavy Mud from Total Depth to 1350 Feet,
Plug and 100 sax Cement; Mud to 245 Feet,
Plug and 25 sax Cement; Mud to 40 Feet,
1/2 sax Halls, Plug bridged w/Kelly and
10 sax Cement to Base of Cellar; 2 sax
Cement in Rat Hole. Job Completed at
4:15 P.M. by Allied Cementing Co.

RECEIVED
STATE CORPORATION COMMISSION
NOV 19 1970
CONSERVATION DIVISION
Wichita, Kansas

(If additional description is necessary, use BACK of this sheet)
Name of Plugging Contractor Allied Cementing Co., Inc. 11-19-1970
Address Box 207, Russell, Kansas

STATE OF KANSAS, COUNTY OF SEDGWICK, ss.
T. M. McCaul, Jr. of Sage Drilling Co. (employee of owner) or (owner or operator) of the above described

well being first duly sworn on oath, says: That I have knowledge of the facts, statements and matters herein contained and the log of the above described well as filed and that the same are true and correct. So help me God.

(Signature) T. M. McCaul, Jr.

500 Bitting Building, Wichita, Kansas
(Address)

Subscribed and sworn to before me this 17th day of November, 1970.

November 26, 1970.

Louise K. Whitted - Notary Public.



15-039-20196-00-00

DRILLERS LOG

TEMPLETON "B" NO. 1

CASING RECORD:	OPERATOR:	Rosen Oil Corporation	DESCRIPTION:
8-5/8" @ 230'	CONTRACTOR:	Sage Drilling Co.	C NE SW
w/175 sax cement	COMMENCED:	November 10, 1970	Sec. 32-1S-29W
TOTAL DEPTH:	COMPLETED:	November 16, 1970	Decatur Co., Kansas
3940'			ELEVATION: 2685KB

<u>FORMATION</u>	<u>FROM</u>	<u>TO</u>	<u>REMARKS</u>
Clay & Rock	0	40	
Sand & Clay	40	150	
Shale	150	231	
Shale & Sand	231	1580	
Lime, Shale & Sand	1580	1885	
Sand & Shale	1885	2436	
Anhydrite	2436	2467	
Lime & Shale	2467	2820	
Shale & Lime	2820	2980	
Lime & Shale	2980	3940	D&A

RECEIVED
STATE CORPORATION COMMISSION
NOV 19 1970
CONSERVATION DIVISION
Wichita, Kansas
11-19-1970

I certify that this is a true and correct copy of the above log to the best of my knowledge.

SAGE DRILLING CO., INC.

By T. M. McCaul, Jr.
T. M. McCaul, Jr.



Subscribed and sworn to before me this 18th day of November, 1970.

Louise K. Whitted
Louise K. Whitted - Notary Public

My commission expires:
November 26, 1970.