


STATE OF KANSAS
STATE CORPORATION COMMISSION

13-039-00147-00-00

Give All Information Completely
Make Required Affidavit
Mail or Deliver Report to:
Conservation Division
State Corporation Commission
211 No. Broadway
Wichita, Kansas

WELL PLUGGING RECORD

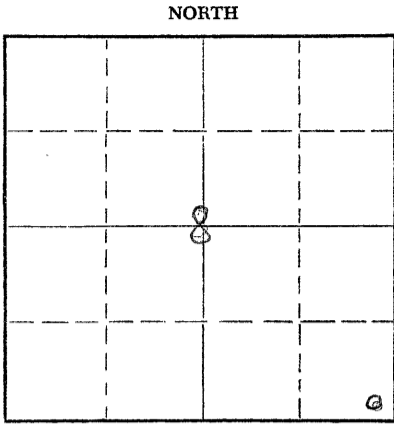

Locate well correctly on above
Section Plat

Decatur County. Sec. 8 Twp. 1S Rge. 29 (E) (W)W
Location as "NE/CNW/SW" or footage from lines SE SE SE
Lease Owner Sauvage Drilling Co., Inc.
Lease Name Brady Well No. 1
Office Address Oberlin, Kansas
Character of Well (completed as Oil, Gas or Dry Hole)
Date well completed 9-10-59 19
Application for plugging filed do 19
Application for plugging approved do 19
Plugging commenced do 19
Plugging completed do 19
Reason for abandonment of well or producing formation dry hole

If a producing well is abandoned, date of last production 19
Was permission obtained from the Conservation Division or its agents before plugging was commenced? yes

Name of Conservation Agent who supervised plugging of this well A. D. Fabricius
Producing formation Depth to top Bottom Total Depth of Well 4197 Feet
Show depth and thickness of all water, oil and gas formations.

OIL, GAS OR WATER RECORDS

CASING RECORD

FORMATION	CONTENT	FROM	TO	SIZE	PUT IN	PULLED OUT
				8-5/8"	195'	Left in hole

Describe in detail the manner in which the well was plugged, indicating where the mud fluid was placed and the method or methods used in introducing it into the hole. If cement or other plugs were used, state the character of same and depth placed, from feet to feet for each plug set.

Filled hole with heavy mud to 500 feet-set plug and cement with 20 sax-filled hole to 190 feet-set plug with 20 sax cement- mud to 40 feet-plug with 10 sax cement and fill hole to bottom of cellar.

RECEIVED
STATE CORPORATION COMMISSION

SEP 14 1959

CONSERVATION DIVISION
Wichita, Kansas

(If additional description is necessary, use BACK of this sheet)
Name of Plugging Contractor Sauvage Drilling Co., Inc.
Address Oberlin, Kansas

9-14-59

STATE OF Kansas, COUNTY OF Decatur, ss.
W. W. Sauvage (employee of owner) or (owner or operator) of the above-described well, being first duly sworn on oath, says: That I have knowledge of the facts, statements, and matters herein contained and the log of the above-described well as filed and that the same are true and correct. So help me God.

(Signature) *W. W. Sauvage*
Oberlin, Kansas (Address)

SUBSCRIBED AND SWORN TO before me this 11th day of September, 1959

My commission expires June 18, 1962
Janice Bryan Notary Public.



PLUGGING

File Sec. 8 T 1 296
Book Page 3 Line 12

DRILLERS LOG

Operator: Sauvage Drilling Co., Inc. Location: SE SE SE 8-1S-29W
 Farm Name: Brady Decatur Co Kansas
 Contractor: Sauvage Drl'g Co., Inc.
 Rotary Tools Surface Casing: 195'
 Commence: 9-3-59 8-5/8"
 Completed: 9-10-59

Figures denote bottom of formations

surface casing	195
shale	1150
shale & broken lime	2320
lime & pyrite	2925
shale & lime	3635
lime	3695
lime & shale	3950
shale, with lime & chert	4050
lime	4197 TD

STATE OF KANSAS)
) SS
 DECATUR COUNTY)

I hereby certify that the foregoing is, to the best of my knowledge and belief, is a true and correct drilling log as shown by the daily drilling reports in connection with the aforesaid well.

RECEIVED
 STATE CORPORATION COMMISSION
 12-21-1959
 DEC 21 1959
 DIVISION

W. W. Sauvage
 W. W. Sauvage

Subscribed and sworn to before me, the undersigned, a Notary Public, this 11th day of September, 1959

Jamie Bryan
 Notary Public

My commission expires June 18 1962