


STATE OF KANSAS  
 STATE CORPORATION COMMISSION

WELL PLUGGING RECORD

Give All Information Completely  
 Make Required Affidavit  
 Mail or Deliver Report to  
 Conservation Division  
 State Corporation Comm.  
 245 North Water  
 Wichita, KS 67202

Decutor \_\_\_\_\_ County. Sec. 13 Twp. 12 Rge. 29 E/W W  
 Location as "NE/CNW $\frac{1}{4}$ SW $\frac{1}{4}$ " or footage from lines \_\_\_\_\_  
 SE NW

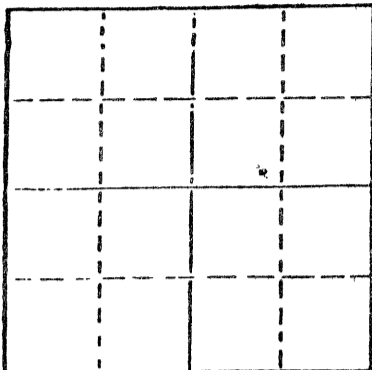

Locate well correctly on above Section Plat

Lease Owner L&F Oil Operators  
 Lease Name Wurm Well No. 1  
 Office Address Box 415 Plainville Kan. 67663  
 Character of Well (Completed as Oil, Gas or Dry Hole) \_\_\_\_\_  
 D&A

Date Well completed \_\_\_\_\_ 19\_\_\_\_  
 Application for plugging filed 4-27-78 \_\_\_\_\_ 1978  
 Application for plugging approved 4-27- \_\_\_\_\_ 1978  
 Plugging commenced 11=00Pm 4-27 \_\_\_\_\_ 1978  
 Plugging completed 2-00 Am 4-28 \_\_\_\_\_ 1978  
 Reason for abandonment of well or producing formation \_\_\_\_\_

If a producing well is abandoned, date of last production \_\_\_\_\_ 19\_\_\_\_  
 Dry

Was permission obtained from the Conservation Division or its agents before plugging was commenced? \_\_\_\_\_

Name of Conservation Agent who supervised plugging of this well Gilbert Balthazor  
 Producing formation \_\_\_\_\_ Depth to top \_\_\_\_\_ Bottom \_\_\_\_\_ Total Depth of Well 4240  
 Show depth and thickness of all water, oil and gas formations.

OIL, GAS OR WATER RECORDS

CASING RECORD

FORMATION	CONTENT	FROM	TO	SIZE	PUT IN	PULLED OUT

Describe in detail the manner in which the well was plugged, indicating where the mud fluid was placed and the method or methods used in introducing it into the hold. If cement or other plugs were used, state the character of same and depth placed, from \_\_\_\_\_ feet to \_\_\_\_\_ feet for each plug set. # 1 Plug set 1500 -70sks 40-60 Posmix 6% Jell

# 2 Plug set 276 - 20sks . . . . .

Solid bridge to surface ALL done through drill pipe  
 STATE CORPORATION COMMISSION

NOV 27 1978

CONSERVATION DIVISION  
 Wichita, Kansas

(If additional description is necessary, use BACK of this sheet) 11-27-1978


Name of Plugging Contractor Rains Williamson

STATE OF Kansas COUNTY OF Rooks, ss.  
Floyd E. Kelly (employee of owner) or (owner or operator)  
 of the above-described well, being first duly sworn on oath, says: That I have knowledge of the facts, statements, and matters herein contained and the log of the above-described well as filed and that the same are true and correct. So help me God.

(Signature) Floyd E Kelly  
Box 415 - Plainville Ks 67663  
 (Address)

SUBSCRIBED AND SWORN TO before me this 21 day of November, 1978

My commission expires \_\_\_\_\_

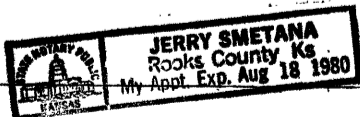

Jerry Smetana  
 Notary Public.

RECEIVED  
 STATE CORPORATION COMMISSION

NOV 13 1978  
 11-13-1978