


WELL PLUGGING RECORD

Give All Information Completely  
Make Required Affidavit  
Mail or Deliver Report to:  
Conservation Division  
State Corporation Commission  
212 No. Market  
Wichita, Kansas

NORTH

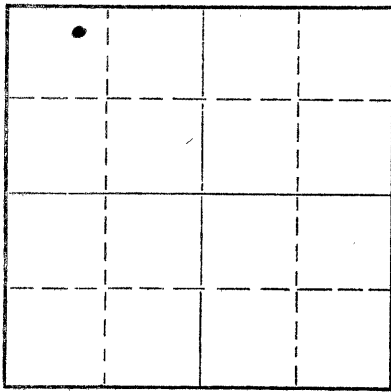

Locate well correctly on above  
Section Plat

Decatur County. Sec. 5 Twp. 1 Rge. (E) 29(W)  
Location as "NE/CNW%SW%" or footage from lines C-NE-NW-NW  
Lease Owner Excalibur Production Co., Inc.  
Lease Name Frank J. Ploussard Well No. # 1  
Office Address Box 231 McPherson, Kansas 67460  
Character of Well (completed as Oil, Gas or Dry Hole) Dry Hole  
Date well completed November 3 19 71  
Application for plugging filed November 3 19 71  
Application for plugging approved November 3 19 71  
Plugging commenced November 4 19 71  
Plugging completed 3:00 A.M. November 4 19 71  
Reason for abandonment of well or producing formation No Oil

If a producing well is abandoned, date of last production None 19       
Was permission obtained from the Conservation Division or its agents before plugging was commenced? Yes

Name of Conservation Agent who supervised plugging of this well W. L. Nichols  
Producing formation      Depth to top      Bottom      Total Depth of Well 3870 Feet  
Show depth and thickness of all water, oil and gas formations.

OIL, GAS OR WATER RECORDS

CASING RECORD

FORMATION	CONTENT	FROM	TO	SIZE	PUT IN	PULLED OUT
See drillers log and geologist report						

Describe in detail the manner in which the well was plugged, indicating where the mud fluid was placed and the method or methods used in introducing it into the hole. If cement or other plugs were used, state the character of same and depth placed, from      feet to      feet for each plug set.

Set plug #1 at 1500 feet with 100 sacks of cement with Halliburton pump truck. Filled hole with heavy drilling mud and set second plug at 215 feet with 25 sacks of cement with Halliburton pump truck. Again filled hole with heavy drilling mud and set plug #3 at 40 feet with a bridge and filled to surface with 10 sacks of cement.

RECEIVED  
STATE CORPORATION COMMISSION  
NOV 9 1971  
CONSERVATION DIVISION  
Wichita, Kansas


(If additional description is necessary, use BACK of this sheet)  
Name of Plugging Contractor Helberg Oil Company with use of Halliburton 11-9-1971  
Address Morland, Kansas 67650

STATE OF Kansas, COUNTY OF Graham, ss.  
Jerry M. Helberg (employee of owner) ~~OK (owner) operator~~ of the above-described well, being first duly sworn on oath, says: That I have knowledge of the facts, statements, and matters herein contained and the log of the above-described well as filed and that the same are true and correct. So help me God.

(Signature) Jerry M. Helberg  
Morland, Kansas 67650  
(Address)

SUBSCRIBED AND SWORN TO before me this 5th day of November 19 71

My commission expires 1973

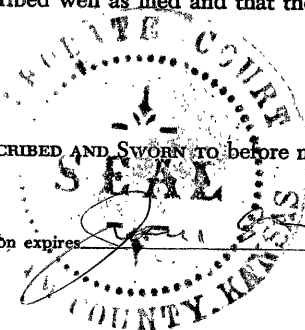

Dwight D. Robinson  
Probate Judge