

CARD MUST BE TYPED

State of Kansas

CARD MUST BE SIGNED

### NOTICE OF INTENTION TO DRILL

(see rules on reverse side)

Starting Date ..... 10.....22.....85.....  
month day year

API Number 15— 153-20,638-00-00

OPERATOR: License # 5011  
Name Viking Resources  
Address 217 E. William  
City/State/Zip Wichita, KS 67202-4005  
Contact Person Jim Devlin  
Phone 316-262-2502

S  $\frac{1}{2}$  S  $\frac{1}{2}$  NW Sec. 16 Twp. 1 S, Rg. 32  
2970 Ft. from South Line of Section  
3960 Ft. from East Line of Section

(Note: Locate well on Section Plat on reverse side)

CONTRACTOR: License # 5420  
Name White and Ellis Drilling, Inc.  
City/State Wichita, KS

Nearest lease or unit boundary line 330 feet  
County Rawlins  
Lease Name Wicke Well # 1

Well Drilled For: Well Class: Type Equipment:  
 Oil  SWD  Infield  Mud Rotary  
 Gas  Inj  Pool Ext.  Air Rotary  
 OWWO  Expl  Wildcat  Cable

Ground surface elevation Est 2970 feet MSL  
Domestic well within 330 feet: —yes  no  
Municipal well within one mile: —yes  no  
Surface pipe by Alternate: 1  2

IF OWWO: old well info as follows:  
Operator  
Well Name  
Comp Date Old Total Depth

Depth to bottom of fresh water 200 225  
Depth to bottom of usable water 200 225  
Surface pipe planned to be set 250 275  
Projected Total Depth 4200 feet  
Formation Base Kansas City

I certify that well will comply with K.S.A. 55-101, et seq., plus eventually plugging hole to KCC specifications.

Date 11 Oct 1985 Signature of Operator or Agent [Signature] Title Operator-Partner


For KCC Use:  
Conductor Pipe Required ..... feet; Minimum Surface Pipe Required ..... feet per Alt. 2  
This Authorization Expires 4-15-86 Approved By [Signature] 10-15-85

Must be filed with the K.C.C. five (5) days prior to commencing well  
This card void if drilling not started within six (6) months of date received by K.C.C.

**Important procedures to follow:**

1. Notify District office before setting surface casing.
2. Set surface casing by circulating cement to the top.
3. File completion forms ACO-1 with K.C.C. within 90 days of well completion, following instructions on ACO-1, side 1, and including copies of wireline logs.
4. Notify District office 48 hours prior to old well workover or re-entry.
5. Prior to filing Intent, prepare a proposed plugging plan in case well is D & A, then obtain approval of plan when calling district office prior to setting surface pipe.
6. Submit plugging report (CP-4) to K. C. C. after plugging is completed.
7. Obtain an approved injection docket number before disposing of salt water.
8. Notify K.C.C. within 10 days when injection commences or terminates.
9. If an alternate 2 completion, cement in the production pipe from below any usable water to surface within 120 days of spud date.

**A Regular Section of Land**  
**1 Mile = 5,280 Ft.**

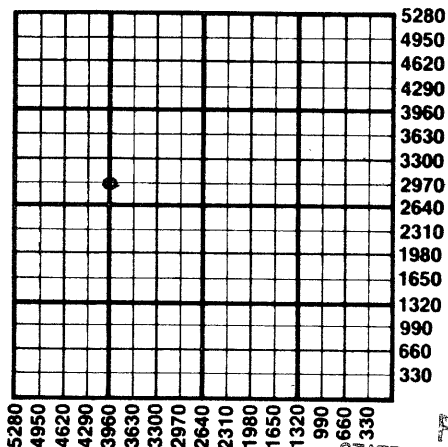

RECEIVED  
STATE CORPORATION COMMISSION

OCT 15 1985  
10-15-1985  
CONSERVATION DIVISION  
Wichita, Kansas

State Corporation Commission of Kansas  
Conservation Division  
200 Colorado Derby Building  
Wichita, Kansas 67202  
(316) 263-3238