

CARD MUST BE TYPED

State of Kansas

CARD MUST BE SIGNED

### NOTICE OF INTENTION TO DRILL

(see rules on reverse side)

Starting Date 3 month 17 day 86 year

API Number 15— 153-20,653-0000

OPERATOR: License # 5011  
Name Viking Resources  
Address 217 E. William  
City/State/Zip Wichita, KS 67202-4005  
Contact Person Jim Devlin  
Phone 316-262-2502

C. E<sup>1</sup>/<sub>2</sub> SE NW Sec. 16 Twp. 1 S, Rg. 32 East  
3300 Ft. from South Line of Section  
2970 Ft. from East Line of Section

(Note: Locate well on Section Plat on reverse side)

CONTRACTOR: License # 5420  
Name White and Ellis Drilling, Inc.  
City/State Wichita, KS

Nearest lease or unit boundary line 330 feet

County Rawlins

Lease Name Wicke Well # 2

Ground surface elevation 2950 est. feet MSL

Well Drilled For: Well Class: Type Equipment:  
 Oil  SWD  Infield  Mud Rotary  
 Gas  Inj  Pool Ext.  Air Rotary  
 OWWO  Expl  Wildcat  Cable

Domestic well within 330 feet:  yes  no

Municipal well within one mile:  yes  no

Surface pipe by Alternate: 1  2

Depth to bottom of fresh water 225

Depth to bottom of usable water 225

Surface pipe planned to be set 280

Projected Total Depth 4200 feet

Formation Base Kansas City

If OWWO: old well info as follows:

Operator .....  
Well Name .....  
Comp Date ..... Old Total Depth.....

I certify that well will comply with K.S.A. 55-101, et seq., plus eventually plugging hole to KCC specifications.

Date 12 February 1986 Signature of Operator or Agent James B. Devlin Title Operator

For KCC Use:

Conductor Pipe Required ..... feet; Minimum Surface Pipe Required 200 feet per Alt. 1


This Authorization Expires 8-13-86 Approved By 2-13-86

Must be filed with the K.C.C. five (5) days prior to commencing well  
 This card void if drilling not started within six (6) months of date received by K.C.C.

**Important procedures to follow:**

1. Notify District office before setting surface casing.
2. Set surface casing by circulating cement to the top.
3. File completion forms ACO-1 with K.C.C. within 90 days of well completion, following instructions on ACO-1, side 1, and including copies of wireline logs.
4. Notify District office 48 hours prior to old well workover or re-entry.
5. Prior to filing Intent, prepare a proposed plugging plan in case well is D & A, then obtain approval of plan when calling district office prior to setting surface pipe.
6. Submit plugging report (CP-4) to K.C.C. after plugging is completed.
7. Obtain an approved injection docket number before disposing of salt water.
8. Notify K.C.C. within 10 days when injection commences or terminates.
9. If an alternate 2 completion, cement in the production pipe from below any usable water to surface within 120 days of spud date.

**A Regular Section of Land**  
 1 Mile = 5,280 Ft.

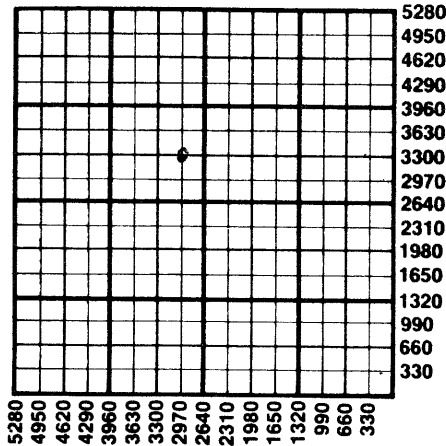

STATE CORPORATION COMMISSION  
 2-13-1986  
 FEB 13 1986

CONSERVATION DIVISION  
 Wichita, Kansas

State Corporation Commission of Kansas  
 Conservation Division  
 200 Colorado Derby Building  
 Wichita, Kansas 67202  
 (316) 263-3238