

CARD MUST BE TYPED

State of Kansas
NOTICE OF INTENTION TO DRILL
HUGOTON INFILL

CARD MUST BE SIGNED
SGA - No

EFFECTIVE DATE 4-26-04

Starting Date 05 01 04
month day year

API Number 15- 093-21748-00-00

DIST. 1 IS SECTION X REGULAR IRREGULAR

OPERATOR: License # 5952
Name BP AMERICA PRODUCTION COMPANY
Address P. O. BOX 3092, WL1, RM 3.201
City/State/Zip HOUSTON, TX 77253-3092
Contact Person SUE SELLERS
Phone (281)366-2052

Ap. SE SE NW NW Sec 19 Twp 23S S, Rg 37W W
1250' N Ft. from South Line of Section
1250' W Ft. from East Line of Section

CONTRACTOR License # 5382
Name CHEYENNE DRILLING
City/State _____
Well Drilled as: X New Recompletion OWWO
Projected Total Depth 2890 feet
Formation CHASE

Note: Attach acreage attribution plat locating both Chase (Hugoton) wells
Total number of acres attributed to unit 640
Nearest producing well from same common source of supply 2037' feet
Nearest lease or unit boundary line 1250' N feet
County KEARNY
Lease Name BELL Well # 3HT
Ground surface elevation 3318 feet MSL
Depth to bottom of fresh water 320
Depth to bottom of usable water 920
Surface pipe by Alternate: 940' min 1 X 2
Surface pipe planned to be set _____
Water Source for Drilled Operations: well _____ farm pond X other _____
DWR Permit #: _____ well _____ farm pond X other _____

If OWWO or Recompletion: old well info as follows:
Operator _____
Well Name _____
Comp. Date _____ Old Total Depth _____

I certify that well will comply with K.S.A. 55-101, et seq., plus eventually plugging hole to KCC specifications
Date 03/08/04 Signature of Operator or Agent Sue Sellers

REGULATORY STAFF
ASSISTANT


For KCC Use:
Conductor Pipe Required NONE feet; Minimum Surface Pipe Required 940 feet per Alt. 1
This Authorization Expires 10-21-04 Approved By RSP 4.21.04

9/95

Must be filed with K.C.C. five (5) days prior to commencing well
This card void if drilling not started within six (6) months of date received by K.C.C.

RECEIVED
APR 12 2004
KCC WICHITA

A Regular Section of Land
1 Mile = 5,280 Ft.

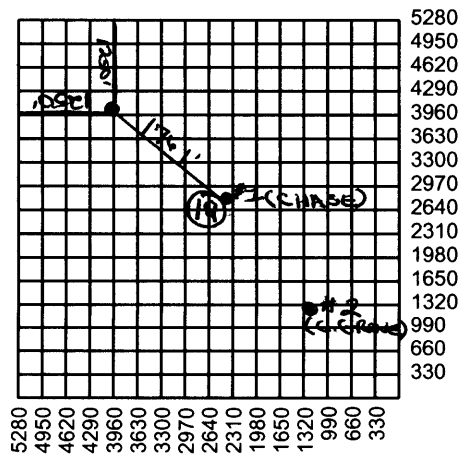

- Important procedures to follow:
1. Notify District office before setting surface casing.
 2. Set surface casing by circulating cement to the top.
 3. File completion forms ACO-1 with K.C.C. within 120 days of well spud date, following instructions on ACO-1, side 1, and including copies of wireline logs.
 4. Notify District office 48 hours prior to old well workover or re-entry.
 5. Submit plugging report (CP-4) to K.C.C. after plugging is completed.
 6. If an alternate 2 completion, cement in the production pipe from below any useable water to surface within 120 day of spud date.

State Corporation Commission of Kansas
Conservation Division
130 S. Market Room 2078
Wichita, Kansas 67202-1212
(316) 337-6231