

RECEIVED

APR 14 2004

KCC WICHITA

Form C-1  
December 2002

Form must be Typed  
Form must be Signed  
All blanks must be Filled

For KCC Use: 4-20-04  
Effective Date: 4  
District # 4  
SGA?  Yes  No

### KANSAS CORPORATION COMMISSION OIL & GAS CONSERVATION DIVISION NOTICE OF INTENT TO DRILL

Must be approved by KCC five (5) days prior to commencing well

Expected Spud Date 4 23 2004  
month day year

Spot Ap 145' w of  
SE SW NW Sec. 31 Twp. 4 S. R. 41  East  West  
2323' feet from  N /  S Line of Section  
845' feet from  E /  W Line of Section  
Is SECTION  Regular  Irregular?

OPERATOR: License# 30282  
Name: Lobo Production, Inc.  
Address: 6715 Road 22  
City/State/Zip: Goodland, KS 67735  
Contact Person: John Sanders  
Phone: 785-899-5684

(Note: Locate well on the Section Plat on reverse side)  
County: CHEYENNE  
Lease Name: O'BRIEN Well #: 2-31  
Field Name: CHERRY CREEK NIOBRARA GAS AREA  
Is this a Prorated / Spaced Field?  Yes  No  
Target Formation(s): Niobrara

CONTRACTOR: License# Schaal Drilling # 33229  
Name: Poe Servicing, Inc. # 3152

Well Drilled For:  Oil  Enh Rec  Infield  Mud Rotary  
 Gas  Storage  Pool Ext.  Air Rotary  
 OWWO  Disposal  Wildcat  Cable  
Seismic: \_\_\_\_\_ # of Holes  Other \_\_\_\_\_  
 Other \_\_\_\_\_

\* Nearest Lease or unit boundary: 845' - (Unit Description Att)  
Ground Surface Elevation: 3542' feet MSL  
Water well within one-quarter mile:  Yes  No  
Public water supply well within one mile:  Yes  No  
Depth to bottom of fresh water: 85' 150  
Depth to bottom of usable water: 150  
Surface Pipe by Alternate:  1  2  
Length of Surface Pipe Planned to be set: 215'  
Length of Conductor Pipe required: none  
Projected Total Depth: 1470'  
Formation at Total Depth: \_\_\_\_\_  
Water Source for Drilling Operations:  Well  Farm Pond Other City Water  
DWR Permit #: \_\_\_\_\_

If OWWO: old well information as follows:  
Operator: \_\_\_\_\_  
Well Name: \_\_\_\_\_  
Original Completion Date: \_\_\_\_\_ Original Total Depth: \_\_\_\_\_

Directional, Deviated or Horizontal wellbore?  Yes  No

If Yes, true vertical depth: \_\_\_\_\_

Bottom Hole Location: \_\_\_\_\_  
KCC DKT #: \_\_\_\_\_

\* Lease = w/2 31-4-41w

### AFFIDAVIT

The undersigned hereby affirms that the drilling, completion and eventual plugging of this well will comply with K.S.A. 55 et. seq.

It is agreed that the following minimum requirements will be met:

1. Notify the appropriate district office **prior** to spudding of well;
2. A copy of the approved notice of intent to drill **shall be** posted on each drilling rig;
3. The minimum amount of surface pipe as specified below **shall be set** by circulating cement to the top; in all cases surface pipe **shall be set** through all unconsolidated materials plus a minimum of 20 feet into the underlying formation.
4. If the well is dry hole, an agreement between the operator and the district office on plug length and placement is necessary **prior to plugging**;
5. The appropriate district office will be notified before well is either plugged or production casing is cemented in;
6. If an ALTERNATE II COMPLETION, production pipe shall be cemented from below any usable water to surface within **120 days** of spud date.  
Or pursuant to Appendix "B" - Eastern Kansas surface casing order #133,891-C, which applies to the KCC District 3 area, alternate II cementing must be completed within 30 days of the spud date or the well shall be plugged. **In all cases, NOTIFY district office** prior to any cementing.

I hereby certify that the statements made herein are true and to the best of my knowledge and belief.

Date: 4/13/04 Signature of Operator or Agent: John Sanders Title: Owner/Operator

**For KCC Use ONLY**  
API # 15 - 023-20556-00-00  
Conductor pipe required NONE feet  
Minimum surface pipe required 200 feet per Alt. 1 §  
Approved by: RJP 4-15-04  
This authorization expires: 10-15-04  
(This authorization void if drilling not started within 6 months of effective date.)  
Spud date: \_\_\_\_\_ Agent: \_\_\_\_\_

### Remember to:

- File Drill Pit Application (form CDP-1) with Intent to Drill;
- File Completion Form ACO-1 within 120 days of spud date;
- File acreage attribution plat according to field proration orders;
- Notify appropriate district office 48 hours prior to workover or re-entry;
- Submit plugging report (CP-4) after plugging is completed;
- Obtain written approval before disposing or injecting salt water.
- If this permit has expired (See: authorized expiration date) please check the box below and return to the address below.

Well Not Drilled - Permit Expired  
Signature of Operator or Agent: \_\_\_\_\_  
Date: \_\_\_\_\_

Mail to: KCC - Conservation Division, 130 S. Market - Room 2078, Wichita, Kansas 67202

3  
4  
41w

**IN ALL CASES PLOT THE INTENDED WELL ON THE PLAT BELOW**

*Plat of acreage attributable to a well in a prorated or spaced field*

**If the intended well is in a prorated or spaced field, please fully complete this side of the form.** If the intended well is in a prorated or spaced field complete the plat below showing that the well will be properly located in relationship to other wells producing from the common source of supply. Please show all the wells and within 1 mile of the boundaries of the proposed acreage attribution unit for gas wells and within 1/2 mile of the boundaries of the proposed acreage attribution unit for oil wells.

API No. 15 - \_\_\_\_\_  
 Operator: Lobo Production, Inc. \_\_\_\_\_  
 Lease: O'BRIEN \_\_\_\_\_  
 Well Number: 2-31 \_\_\_\_\_  
 Field: CHERRY CREEK NIOBRARA GAS AREA \_\_\_\_\_

Number of Acres attributable to well: \_\_\_\_\_  
 QTR / QTR / QTR of acreage: SE - SW - NW

Location of Well: County: CHEYENNE  
 \_\_\_\_\_  
 2323' feet from  N /  S Line of Section  
 845' feet from  E /  W Line of Section  
 Sec. 31 Twp. 4 S. R. 41  East  West

Is Section:  Regular or  Irregular



**If Section is Irregular, locate well from nearest corner boundary.**

Section corner used:  NE  NW  SE  SW

**PLAT**

*(Show location of the well and shade attributable acreage for prorated or spaced wells.)*

*(Show footage to the nearest lease or unit boundary line.)*

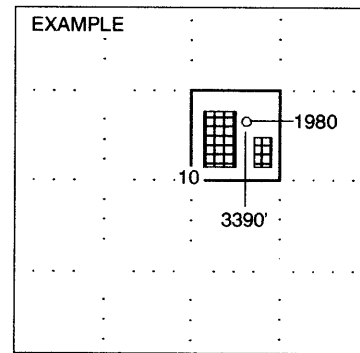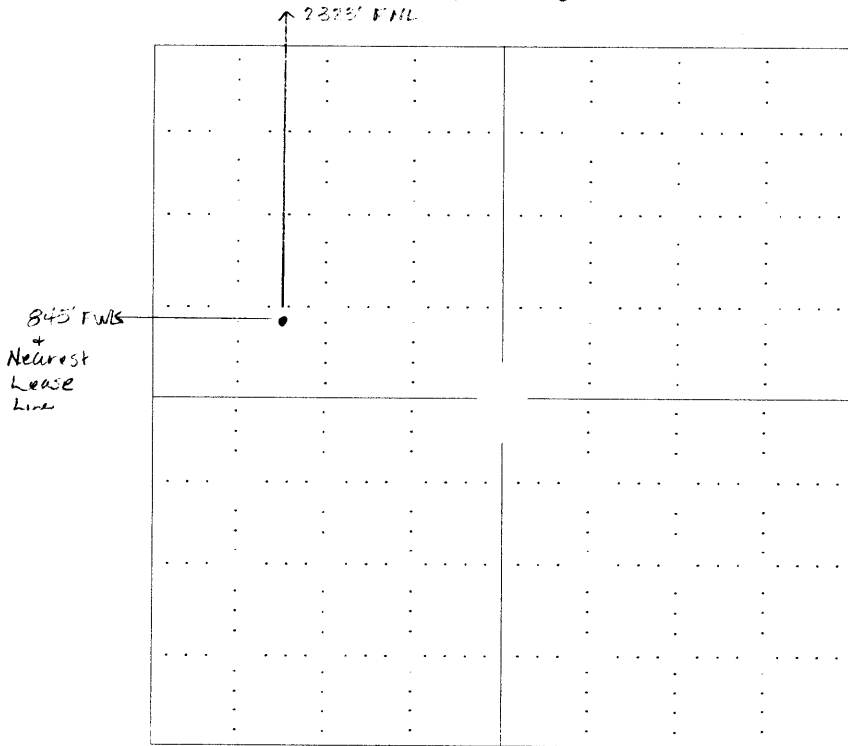

**NOTE: In all cases locate the spot of the proposed drilling locaton.**

**In plotting the proposed location of the well, you must show:**

1. The manner in which you are using the depicted plat by identifying section lines, i.e. 1 section, 1 section with 8 surrounding sections, 4 sections, etc.
2. The distance of the proposed drilling location from the section's south / north and east / west.
3. The distance to the nearest lease or unit boundary line.
4. If proposed location is located within a prorated or spaced field a certificate of acreage attribution plat must be attached: (CO-7 for oil wells; CG-8 for gas wells).