

CARD MUST BE TYPED

State of Kansas  
NOTICE OF INTENTION TO DRILL  
HUGOTON INFILL

CARD MUST BE SIGNED

SGA-No

EFFECTIVE DATE 4-7-04

Starting Date 05 01 04  
month day year

API Number 15- 187-21032-00-00

IS SECTION  REGULAR  IRREGULAR

OPERATOR: License # 5952 ✓  
Name BP AMERICA PRODUCTION COMPANY  
Address P. O. BOX 3092, WL1, RM 3.201  
City/State/Zip HOUSTON, TX 77253-3092  
Contact Person SUE SELLERS  
Phone (281)366-2052 ✓

CONTRACTOR License # 5382  
Name CHEYENNE DRILLING, Inc  
City/State

Well Drilled as:  New  Recompletion  OWWO  
Projected Total Depth 2650 feet  
Formation CHASE

If OWWO or Recompletion: old well info as follows:  
Operator \_\_\_\_\_  
Well Name \_\_\_\_\_  
Comp. Date \_\_\_\_\_

KANSAS CORPORATION COMMISSION

FEB 24 2004

CONSERVATION DIVISION  
WICHITA, KS

C SE SE Sec 12 Twp 30S S, Rg 40W W  
600' S Ft. from South Line of Section ✓  
600' E Ft. from East Line of Section

Note: Attach acreage attribution plat locating both Chase (Hugoton) wells  
Total number of acres attributed to unit 640

Nearest producing well from  
same common source of supply 2787' feet ✓  
Nearest lease or unit boundary line 600' S feet

County STANTON  
Lease Name SPRUNGER Well # 3 HI ✓  
Ground surface elevation 3235 feet MSL

Depth to bottom of fresh water 580  
Depth to bottom of usable water 620  
Surface pipe by Alternate: 1 X 2

Surface pipe planned to be set 640' MIN  
Water Source for Drilled Operations:  
DWR Permit #: \_\_\_\_\_ well \_\_\_\_\_ farm pond  other \_\_\_\_\_

W.L.E. GRANTED 3-30-04

I certify that well will comply with K.S.A. 55-101, et seq., plus eventually plugging hole to KCC specifications.

Date 02/03/04 Signature of Operator or Agent Sue Sellers Title

REGULATORY STAFF  
ASSISTANT

For KCC Use:


Conductor Pipe Required NONE feet; Minimum Surface Pipe Required 640 feet per Alt.

This Authorization Expires 10-3-04 Approved By RJP 4-2-04

9/95

Must be filed with K.C.C. five (5) days prior to commencing well  
This card void if drilling not started within six (6) months of date received by K.C.C.

A Regular Section of Land  
1 Mile = 5,280 Ft.

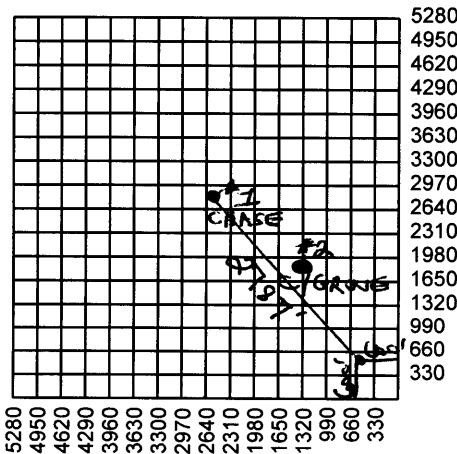

Important procedures to follow:

1. Notify District office before setting surface casing.
2. Set surface casing by circulating cement to the top.
3. File completion forms ACO-1 with K.C.C. within 120 days of well spud date, following instructions on ACO-1, side 1, and including copies of wireline logs.
4. Notify District office 48 hours prior to old well workover or re-entry.
5. Submit plugging report (CP-4) to K.C.C. after plugging is completed.
6. If an alternate 2 completion, cement in the production pipe from below any useable water to surface within 120 day of spud date.

State Corporation Commission of Kansas  
Conservation Division  
130 S. Market Room 2078  
Wichita, Kansas 67202-1212  
(316) 337-6231

12  
30  
400