


WELL PLUGGING RECORD

Give All Information Completely
Make Required Affidavit
Mail or Deliver Report to:
Conservation Division
State Corporation Commission
211 No. Broadway
Wichita, Kansas

NORTH

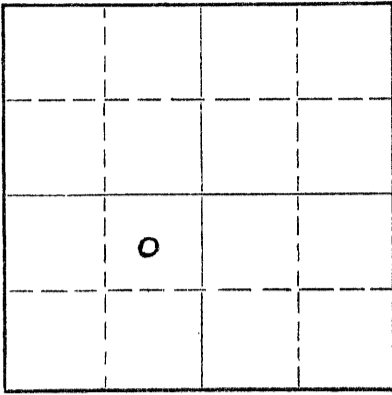

Locate well correctly on above
Section Plat

Rawlins County, Sec. 15 Twp 1S Rge 32 (~~XXX~~ (W)
Location as "NE/CNW/SW" or footage from lines C NE SW
Lease Owner Rains & Williamson Oil Co.
Lease Name Kastens Well No. 1
Office Address 412 Union Center, Wichita 2, Kansas
Character of Well (completed as Oil, Gas or Dry Hole) dry hole
Date well completed 5/9/62 19____
Application for plugging filed 5/9/62 19____
Application for plugging approved 5/9/62 19____
Plugging commenced 5/9/62 19____
Plugging completed 5/9/62 19____
Reason for abandonment of well or producing formation no oil or gas found
in commercial quantities
If a producing well is abandoned, date of last production _____ 19____
Was permission obtained from the Conservation Division or its agents before plugging was com-
menced? yes

Name of Conservation Agent who supervised plugging of this well Eldon Petty
Producing formation _____ Depth to top _____ Bottom _____ Total Depth of Well 4200 Feet
Show depth and thickness of all water, oil and gas formations.

OIL, GAS OR WATER RECORDS

CASING RECORD

FORMATION	CONTENT	FROM	TO	SIZE	PUT IN	PULLED OUT
				8 5/8"	292'	NONE

Describe in detail the manner in which the well was plugged, indicating where the mud fluid was placed and the method or methods used in introducing it into the hole. If cement or other plugs were used, state the character of same and depth placed, from _____ feet to _____ feet for each plug set.

Set plug at 280 feet and 1/4 sacks hulls and 25 sacks cement.
Filled hole up to 40' of base of cellar and cemented with 10 sacks
cement on top of plug and 1/4 sacks of hulls

RECEIVED
STATE CORPORATION COMMISSION
MAY 9 1 1962
CONSERVATION DIVISION
5-21-1962

(If additional description is necessary, use BACK of this sheet)

Name of Plugging Contractor Rains & Williamson Oil Co.
Address 412 Union Center, Wichita 2, Kansas

STATE OF KANSAS, COUNTY OF SEDGWICK, ss.
Wilson Rains, Partner (employee of owner) or (owner or operator) of the above-described well, being first duly sworn on oath, says: That I have knowledge of the facts, statements, and matters herein contained and the log of the above-described well as filed and that the same are true and correct. So help me God.

(Signature) Wilson Rains
Wilson Rains - Partner
412 Union Center, Wichita 2, Kansas
(Address)

SUBSCRIBED AND SWORN TO before me this 18th day of May, 1962

My commission expires JANET JOHNSON
My commission expires Jan. 25, 1965

Janet Johnson
Janet Johnson Notary Public.



15-153-052 50-00-00

ROTARY DRILLING LOG

Operator: H. E. Bangert & Rains & Williamson Oil Co.
No. 1 KASTENS

C NE SW of Sec. 15-18-32W,
Rawlins County, Kansas

CONTRACTOR: Rains & Williamson Oil Co.
COMM: 4-30-62
COMP: 5-9-62

Remarks: set 8 5/8" surface casing
at 292' 3/225 sx Posmix HA5

Formations:

Surface Soil and Sand	71'
Sand & Shale	247'
Shale	292'
Shale	1155'
Shale & Shells	1777'
Shale	2170'
Shale & Lime	2385'
Shale & Lime	2640'
Shale	2718'
Anhydrite	2765'
Shale & Lime	2875'
Shale & Lime	3030'
Lime & Shale	3235'
Shale & Lime	3380'
Lime & Shale	3465'
Lime & Shale	3565'
Lime	3770'
Lime	3900'
Lime & Shale	3960'
Shale & Lime	3974'
Lime & Shale	4010'
Shale & Lime	4075'
Lime	4080'
Lime & Shale	4160'
Lime	4200'
Rotary Total Depth (D&A)	4200'

RECEIVED
STATE CORPORATION COMMISSION

MAY 21 1962

CONSERVATION DIVISION
Topeka, Kansas

5-21-1962

We certify the above log is true
and correct to the best of our
knowledge and belief.

RAINS & WILLIAMSON OIL CO.

By: *Wilson Rains*
Wilson Rains
Partner