

15-153-20397-00-00

STATE OF KANSAS
STATE CORPORATION COMMISSION

WELL PLUGGING RECORD

Give All Information Completely
Make Required Affidavit
Mail or Deliver Report to
Conservation Division
State Corporation Comm.
245 North Water
Wichita, KS 67202

Rawlins County. Sec. 16 Twp. 1S Rge. 32W E/W
Location as "NE/CNW $\frac{1}{4}$ SW $\frac{1}{4}$ " or footage from lines
SE SE

Lease Owner Stoepfelwerth Drilling, Inc.
Lease Name Wicke Well No. 16-13
Office Address 2005 Norris, McCook, NE 69001
Character of Well (Completed as Oil, Gas or Dry Hole)
Dryhole


Date Well completed 9/12 1980
Application for plugging filed 9/12 1980
Application for plugging approved 9/12 1980
Plugging commenced 9/12 1980
Plugging completed 9/12 1980

Reason for abandonment of well or producing formation
Dryhole

If a producing well is abandoned, date of last production
9/12 1980

Was permission obtained from the Conservation Division or
its agents before plugging was commenced? Yes

Name of Conservation Agent who supervised plugging of this well Balthazor
Producing formation None Depth to top Bottom Total Depth of Well
Show depth and thickness of all water, oil and gas formations.

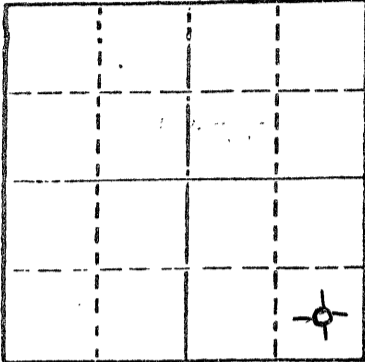

Locate well correctly on above
Section Plat

OIL, GAS OR WATER RECORDS

CASING RECORD

| FORMATION | CONTENT | FROM | TO | SIZE | PUT IN | PULLED OUT |
|-------------------|---------|------|-----|-------|--------|------------|
| All below surface | Water | 0 | 250 | 8-5/8 | 248 | 0 |
| | | | | | | |
| | | | | | | |
| | | | | | | |

Describe in detail the manner in which the well was plugged, indicating where the mud fluid was placed and the method or methods used in introducing it into the hold. If cement or other plugs were used, state the character of same and depth placed, from _____ feet to _____ feet for each plug set.

Balanced Plugs

100sx @ 1050
25sx @ 250
10sx @ 40
5sx in R.H.

RECEIVED
STATE CORPORATION COMMISSION
OCT - 3 1980
CONSERVATION DIVISION
Wichita, Kansas

(If additional description is necessary, use BACK of this sheet)

Name of Plugging Contractor Halliburton Drilling, Inc. 10-3-1980

STATE OF NEBRASKA COUNTY OF RED WILLOW, ss.
George P. Stoepfelwerth (employee of owner) or (owner or operator)
of the above-described well, being first duly sworn on oath, says: That I have knowledge of the facts, statements, and matters herein contained and the log of the above-described well as filed and that the same are true and correct. So help me God.

(Signature)

2005 Norris, McCook, Nebraska 69001
(Address)

SUBSCRIBED AND SWORN TO before me this 26th day of September, 1980



Robert Lewis
Notary Public.

My commission expires