

Give All Information Completely  
Make Required Affidavit  
Mail or Deliver Report to:  
Conservation Division  
State Corporation Commission  
212 No. Market  
Wichita, Kansas

WELL PLUGGING RECORD

15-153-20010-00-00

Rawlins County, Sec. 18 Twp. 1S Rge. (E) 31(W)

Location as "NE/CNW/SW" or footage from lines. C NW NE

Lease Owner Abercrombie Drilling, Inc.

Lease Name SATTLER Well No. 1

Office Address 801 Union Center Wichita, Kansas 67202

Character of Well (completed as Oil, Gas or Dry Hole) Dry Hole

Date well completed May 27, 1967

Application for plugging filed May 26, 1967

Application for plugging approved May 26, 1967


Plugging commenced May 26, 1967

Plugging completed May 27, 1967

Reason for abandonment of well or producing formation Dry Hole

If a producing well is abandoned, date of last production 19

Was permission obtained from the Conservation Division or its agents before plugging was commenced? Yes

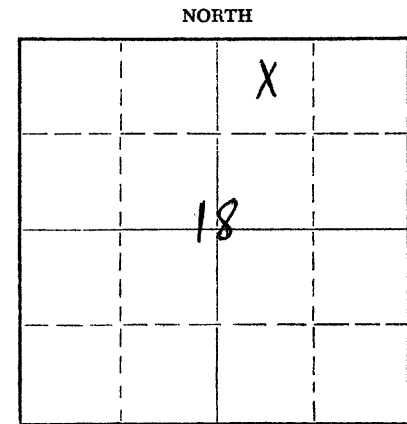

Locate well correctly on above Section Plat

Name of Conservation Agent who supervised plugging of this well W. L. Nichols, Morland, Kansas

Producing formation \_\_\_\_\_ Depth to top \_\_\_\_\_ Bottom \_\_\_\_\_ Total Depth of Well 4107 Feet

Show depth and thickness of all water, oil and gas formations.

OIL, GAS OR WATER RECORDS

CASING RECORD

FORMATION	CONTENT	FROM	TO	SIZE	PUT IN	PULLED OUT
				7"	288'	None

Describe in detail the manner in which the well was plugged, indicating where the mud fluid was placed and the method or methods used in introducing it into the hole. If cement or other plugs were used, state the character of same and depth placed, from \_\_\_\_\_ feet to \_\_\_\_\_ feet for each plug set.

1st plug was set at 660' w/15 sx.

2nd plug was set at 300' w/15 sx.

Top plug was set at 40' w/10 sx.

Job was completed at 3:30 A.M. on 5/27/67.

RECEIVED  
STATE CORPORATION COMMISSION  
JUN 5 1967  
06-05-1967  
CONSERVATION DIVISION  
Wichita, Kansas

(If additional description is necessary, use BACK of this sheet)

Name of Plugging Contractor Paine Drilling Company

Address Hill City, Kansas

STATE OF Kansas, COUNTY OF Sedgwick, ss. Jack K. Wharton (employee of owner) or (owner or operator) of the above-described

well, being first duly sworn on oath, says: That I have knowledge of the facts, statements, and matters herein contained and the log of the above-described well as filed and that the same are true and correct. So help me God.

(Signature) Jack K. Wharton  
ABERCROMBIE DRILLING, INC.  
801 Union Center, Inc.  
(Address)

SUBSCRIBED AND SWORN to before me this 2nd day of June, 1967

My commission expires October 8, 1969

DARLA VALDOIS

Notary Public.

DRILLER'S WELL LOG

COMPANY: ABERCROMBIE DRILLING, INC.  
 CONTRACTOR: PAINE DRILLING CO., INC.  
 WELL: SATTLER  
 LOCATION: C NW NE Sec. 18-1S-31W  
 Rawlins County Kansas  
 COMMENCED: May 17, 1967  
 COMPLETED: May 26, 1967

15-153-20010-00-00

0	137	Shale & Sand
137	1060	Shale
1060	1660	Shale & Sand
1660	1950	Shale & Shells
1950	2085	Shale & Sand
2085	2290	Red Bed
2290	2540	Shale & Shells
2540	2650	Shale & Pyrite
2650	2686	Sand & Pyrite
2686	2727	Anhyrite
2727	3017	Shale
3017	3770	Shale & Lime
3770	3930	Lime & Shale
3930	4107	Lime

**RECEIVED**  
 STATE CORPORATION COMMISSION  
 JUN 5 1967  
 06-05-1967  
 CONSERVATION DIVISION  
 Wichita, Kansas

Set 7" surface pipe at 288 with 150 sacks cement

DRY & ABANDONED

We hereby certify that the above is a correct and accurate log of the above mentioned well, as shown on the daily drilling reports

PAINE DRILLING CO., INC.

*C. B. Paine*

Subscribed and sworn to before me this 1st day of June, 1967

*Donald Law*  
Notary Public

My Commission Expires May 25 1968