

STATE OF KANSAS
STATE CORPORATION COMMISSION

15-153-20302-00-00

WELL PLUGGING RECORD

Give All Information Completely
Make Required Affidavit
Mail or Deliver Report to
Conservation Division
State Corporation Comm.
245 North Water
Wichita, KS 67202

Rawlins County. Sec. 3 Twp. 1S Rge. 31
Location as "NE/CNW 1/4 SW 1/4" or footage from lines
C SW/4 NE/4


Lease Owner Gerald Cohl, Et al.
Lease Name Pettera Well No. 1
Office Address 601 W. 5th St./Suite M140/Los Angeles
Character of Well (Completed as Oil, Gas or Dry Hole) CA.
Oil Well

Date Well completed August 11, 1979
Application for plugging filed July 28, 1983
Application for plugging approved August 25, 1983
Plugging commenced October 25, 1983
Plugging completed October 25, 1983
Reason for abandonment of well or producing formation

Reservoir Depleted
If a producing well is abandoned, date of last production
September 15, 1983

Was permission obtained from the Conservation Division or
its agents before plugging was commenced? Yes

Name of Conservation Agent who supervised plugging of this well Carl Goorow
Producing formation L-KC Depth to top 3896 Bottom 4150 Total Depth of Well 4578
Show depth and thickness of all water, oil and gas formations.

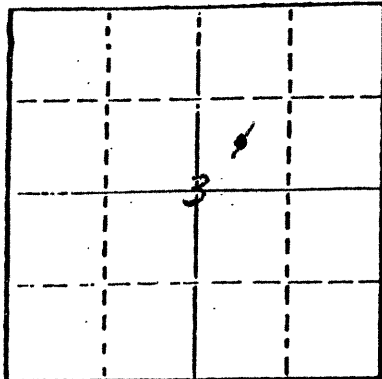

Locate well correctly on above
Section Plot

OIL, GAS OR WATER RECORDS

CASING RECORD

FORMATION	CONTENT	FROM	TO	SIZE	PUT IN	PULLED OUT
L-KC	OIL	3896	4150	8 5/8"	346'	0
MISS.	OIL	4338	4422	4 1/2"	4469'	0

Describe in detail the manner in which the well was plugged, indicating where the mud fluid was placed and the method or methods used in introducing it into the hold. If cement or other plugs were used, state the character of same and depth placed, from _____ feet to _____ feet for each plug set.

Spotted 10 sx. 50/50 poz-mix (6% gel 3% CaCl) on CIBP @ 4170' in 4 1/2" csg. Mixed in 200# Hulls and pumped down 240 sxs 50-50 poz-mix (6% gel 3% CaCl) behind, in 4 1/2" csg. Pumped 25 sxs 50-50 poz (6% gel 3% CaCl) in 8 5/8 - 4 1/2 annulus, filled to surface. Pumped 25 sx down 4 1/2 csg with plug set @ ± 380'.

(If additional description is necessary, use BACK of this sheet)

Name of Plugging Contractor Sun Oil Well Cementing

STATE OF Kansas COUNTY OF Barton, ss.
Steve Cruickshank (employee of owner) or ~~owner~~ or ~~operator~~
of the above-described well, being first duly sworn on oath, says: That I have knowledge of the facts, statements, and matters herein contained and the log of the above-described well as filed and that the same are true and correct. So help me God.

(Signature) Steve Cruickshank
1020 HOOPER Great Bend, Ks
(Address)

SUBSCRIBED AND SWORN TO before me this 31st day of October, 1983

Thomas H M Glenn
Notary Public.

My commission expires 10-26-87

