


Give All Information Completely
Make Required Affidavit
Mail or Deliver Report to:
Conservation Division
State Corporation Commission
800 Bittling Building
Wichita, Kansas

WELL PLUGGING RECORD

15-153-05210-00-00

NORTH

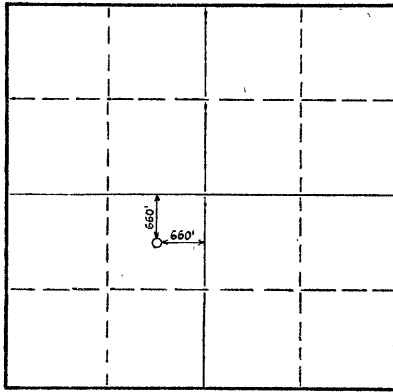

Locate well correctly on above
Section Plat

Rawlins County. Sec. 10 Twp. 1-S Rge. 31-W(E) (W)
Location as "NE/CNW/SW" or footage from lines Center NE/4 of SW/4
Lease Owner Columbian Fuel Corporation
Lease Name Edmund Unger Well No. 1
Office Address 1003 Fisk Building, Amarillo, Texas
Character of Well (completed as Oil, Gas or Dry Hole) Dry hole
Date well completed October 28, 1954 19
Application for plugging filed October 28, 1954 19
Application for plugging approved Oct. 28, 1954 by phone Eldon Petty 19
Plugging commenced October 28, 1954 19
Plugging completed October 28, 1954 19
Reason for abandonment of well or producing formation Dry hole

If a producing well is abandoned, date of last production None 19
Was permission obtained from the Conservation Division or its agents before plugging was commenced? Yes

Name of Conservation Agent who supervised plugging of this well Eldon Petty - Hays, Kansas
Producing formation _____ Depth to top _____ Bottom _____ Total Depth of Well 2540 Feet
Show depth and thickness of all water, oil and gas formations.

OIL, GAS OR WATER RECORDS

CASING RECORD

FORMATION	CONTENT	FROM	TO	SIZE	PUT IN	PULLED OUT
				8 5/8"	282	None

Describe in detail the manner in which the well was plugged, indicating where the mud fluid was placed and the method or methods used in introducing it into the hole. If cement or other plugs were used, state the character of same and depth placed, from _____ feet to _____ feet for each plug set.

2540' to 270' - 9.5#, 37 Vis., Mud
270' to 225' - Common Cement - 15 sacks
225' to 40' - 9.5#, 37 Vis., Mud
40' to 0' - Common Cement - 10 sacks

(If additional description is necessary, use BACK of this sheet)

Name of Plugging Contractor Company
Address _____

STATE OF Texas, COUNTY OF Potter, ss.
Robert Grady (employee of owner) or (owner or operator) of the above-described well, being first duly sworn on oath, says: That I have knowledge of the facts, statements, and matters herein contained and the log of the above-described well as filed and that the same are true and correct. So help me God.


(Signature) Robert Grady
1003 Fisk Bldg. Amarillo, Tex
(Address)

SUBSCRIBED AND SWORN TO before me this First day of November, 1954

Calvin Lindsey
Notary Public.

My commission expires June 1, 1955

cc: Eldon Petty
Victor Cotner
Harvey Hagens
File

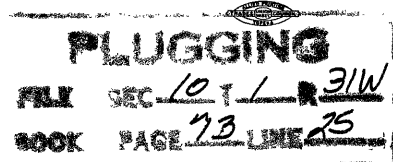

11-05-1954

Columbian Fuel Corporation

LOG OF WELL

15-153-05210-00-00

Well Name: Edmund Unger
GW: 1151
Location: Center NE SW Section 10, Township 1, Range 31-W, Rawlins County, Kansas

Date Commenced: October 24, 1954
Date Completed: October 28, 1954
Contractor: Midwestern Drillers
Production: Dry hole


0	40	Sand and gyp
40	250	Sand and gravel
250	288	Yellow clay
288	810	Clay and shale
810	1250	Shale and shells
1250	1617	Shale and lime
1617	1835	Shale
1835	2540	Shale and sand

Casing Record
8 5/8"

282'

200 sacks cement

Original: Corporation Commission
cc: R. G. Merrick
Victor Cotner
R. A. Cover
Harvey Hagens
File

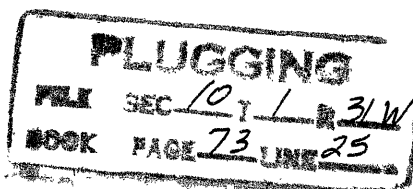

15-153-05210-00-00

LOG OF WELL

CODE 1151 Columbian Fuel Corporation SHEET 1
(COMPANY)

STATE Kansas DISTRICT 129 Herndon COUNTY Rawlins

LEASE E. Unger WELL NO. 1 SEC. 10 TWP. 1-S R. 31-W

DATE OF LOG November 1, 1954 LOCATION IN SEC. Center NE SW

LOCATION MADE Sept. 29, 1954 COMM. RIGGING UP Oct. 23, '54 COMM. DRILLING Oct. 24, '54 COMP. DRILLING Oct. 28, '54

TOTAL DEPTH 2540 ELEVATION 2910 STATE PERMIT NO. _____

DAY DRILLER P. Jones NIGHT DRILLER Jr. Glover CONTRACTOR Midwestern

CABLE TOOLS FROM NONE ROTARY TOOLS FROM 0 TO 2540

OPEN FLOW CAPACITY None M. CU. FT. ROCK PRESSURE _____ GASOLINE CONTENT PER M. CU. FT. _____

DEPTH IN SAND _____ PRODUCING SANDS AND THICKNESS OF EACH None

PRODUCTION FIRST 24 HOURS _____ SETTLED PRODUCTION _____ STARTED PRODUCTION _____

DATE TUBED _____ SYPHON SET _____ SIZE _____ FEET _____

CASING RECORD

SIZE	WEIGHT	PUT IN WELL		PULLED OUT		LEFT IN WELL		SHOES		PACKERS		
		FEET	IN.	FEET	IN.	FEET	IN.	LENGTH	MAKE	KIND	LENGTH	SET AT
8 5/8"	24#	282		NONE								

LINER: STATE SIZE AND WEIGHT _____ WHERE SET _____ FT. AND INS. BLANK _____ FT. AND INS. PERFORATED _____

HOW PUT TOGETHER _____ COUPLING _____ FLUSH-JOINT _____ INSERTED _____

REMARKS _____

EQUIPMENT RECORD

TUBING				SUCKER RODS			PUMPING OUTFIT
SIZE	WEIGHT	FEET	IN.	FEET	IN.	SIZE AND KIND	DESCRIPTION, KIND, SIZE, ETC.

KIND OF SHOT _____ SIZE OF SHOT QUARTS _____ NUMBER OF SHOTS _____

NUMBER OF SHELLS _____ SIZE OF SHELLS _____ INCHES, DIAMETER _____

LENGTH OF SHELLS _____ FT. _____ INS. SHOT FURNISHED BY _____ TOP OF SHOT _____

BOTTOM OF SHOT _____ ANCHOR _____ WELL BRIDGED TO _____

PRODUCTION BEFORE SHOT _____ PRODUCTION AFTER SHOT _____

NAME OF SHOOTER _____ SHOT INSPECTED _____ BY _____ (COMPANY EMPLOYEE)

COMMENCED DRILLING DEEPER _____ COMPLETED DRILLING DEEPER _____

TOTAL DEPTH _____ PRODUCTION FIRST 24 HOURS _____ SETTLED PRODUCTION _____

REMARKS: Completed as dry hole and plugged

PLUGGING
 FILE SEC 10 T 1 R 31W

NOTE: IF WELL WAS DRY, STATE UNDER REMARKS, WHEN, HOW, AND BY WHOM PLUGGED. STATE UNDER REMARKS ANYTHING OF INTEREST NOT COVERED IN LOG. IF SPACE PROVIDED FOR REMARKS IS NOT SUFFICIENT WRITE ON BOTTOM OF LAST SHEET OF LOG.