


Give All Information Completely  
Make Required Affidavit  
Mail or Deliver Report to:  
Conservation Division  
State Corporation Commission  
800 Biting Building  
Wichita, Kansas

WELL PLUGGING RECORD

15-153-00029-00-00

Rawlins County. Sec. 18 Twp. 1-S Rge. 31-W(E) (W)

Location as "NE/CNW/SW" or footage from lines Center NW/4 of SE/4  
Lease Owner Columbian Fuel Corporation  
Lease Name Elizabeth Solko Well No. 1  
Office Address 1003 Fisk Building, Amarillo, Texas  
Character of Well (completed as Oil, Gas or Dry Hole) Dry hole  
Date well completed October 22, 1954 19  
Application for plugging filed October 22, 1954 19  
Application for plugging approved Oct. 22, 1954 by phone Eldon Petty 19  
Plugging commenced October 22, 1954 19  
Plugging completed October 22, 1954 19  
Reason for abandonment of well or producing formation Dry hole

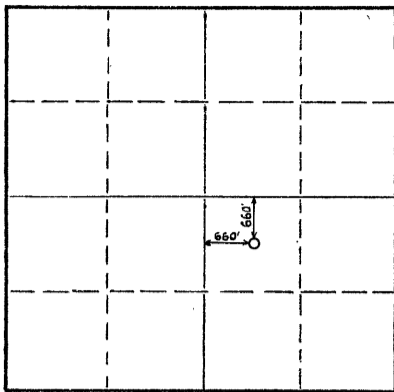

Locate well correctly on above Section Plat

If a producing well is abandoned, date of last production None 19  
Was permission obtained from the Conservation Division or its agents before plugging was commenced? Yes

Name of Conservation Agent who supervised plugging of this well Eldon Petty - Hays, Kansas  
Producing formation None Depth to top \_\_\_\_\_ Bottom \_\_\_\_\_ Total Depth of Well 2520 Feet  
Show depth and thickness of all water, oil and gas formations.

OIL, GAS OR WATER RECORDS

CASING RECORD

FORMATION	CONTENT	FROM	TO	SIZE	PUT IN	PULLED OUT
				8 5/8"	321'	None

Describe in detail the manner in which the well was plugged, indicating where the mud fluid was placed and the method or methods used in introducing it into the hole. If cement or other plugs were used, state the character of same and depth placed, from \_\_\_\_\_ feet to \_\_\_\_\_ feet for each plug set.

2520' to 300' - 9.5#, 37 Vis., Mud  
300' to 240' - Common Cement - 20 sacks  
240' to 40' - 9.5#, 37 Vis., Mud  
40' to 0' - Common Cement - 10 sacks

(If additional description is necessary, use BACK of this sheet)

Name of Plugging Contractor Company  
Address \_\_\_\_\_

STATE OF Texas, COUNTY OF Potter, ss.  
Robert Grady (employee of owner) or (owner or operator) of the above-described well, being first duly sworn on oath, says: That I have knowledge of the facts, statements, and matters herein contained and the log of the above-described well as filed and that the same are true and correct. So help me God.

(Signature) Robert Grady  
1003 Fisk Bldg Amarillo Texas (Address)

SUBSCRIBED AND SWORN TO before me this First day of November, 1954

Calvin Lindsey  
Notary Public.

My commission expires June 1, 1955

cc: Eldon Petty  
Victor Cotner  
Harvey Hagins  
File

PLUGGING  
FILE SEC 18 T 1 R 31W  
BOOK PAGE 72 LINE 41

11-3-54

Columbian Fuel Corporation

15-153-00029-00-00 LOG OF WELL


Well Name: Elizabeth Solko  
CW: 1152  
Location: Center NW SE Section 18, Township 1-S, Range 31-W, Rawlins County,  
Kansas

Date Commenced: October 17, 1954  
Date Completed: October 22, 1954  
Contractor: Midwestern Drillers  
Production: Dry hole

0	120	Sand and shale
120	204	Sand and gyp
204	327	Gravel and blue shale
327	1330	Shale and clay
1330	1420	Shale
1420	1695	Shale and lime
1695	1710	Sand
1710	1950	Lime and shale
1950	2300	Sandy shale
2300	2310	Shale
2310	2520	Shale and lime
	2520	Total Depth

Casing Record  
8 5/8" 321' 200 sacks cement

Original: Corporation Commission  
cc: R.G. Merrick  
Victor Cotner  
R. A. Cover  
Harvey Hagens  
File

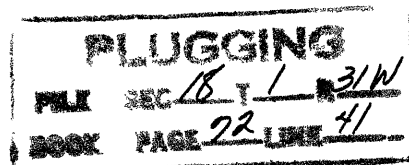

# LOG OF WELL

15-153-00029-00-00

CODE 1152 Columbian Fuel Corporation SHEET 1  
(COMPANY)

STATE Kansas DISTRICT 129 Herndon COUNTY Rawlins

LEASE E. Solko WELL NO. 1 SEC. 18 TWP. 1-S R. 31-W

DATE OF LOG November 1, 1954 LOCATION IN SEC. Center NW - SE

LOCATION MADE Sept. 29, 1954 COMM. RIGGING UP Oct. 17, 1954 COMM. DRILLING Oct. 17, 1954 COMP. DRILLING Oct. 22, 1954

TOTAL DEPTH 2520 ELEVATION 2930 STATE PERMIT NO. \_\_\_\_\_

DAY DRILLER B. Watson NIGHT DRILLER Jr. Glover CONTRACTOR Midwestern

CABLE TOOLS FROM NONE ROTARY TOOLS FROM 0 TO 2520

OPEN FLOW CAPACITY None M. CU. FT. ROCK PRESSURE None GASOLINE CONTENT PER M. CU. FT. \_\_\_\_\_

DEPTH IN SAND \_\_\_\_\_ PRODUCING SANDS AND THICKNESS OF EACH None

PRODUCTION FIRST 24 HOURS \_\_\_\_\_ SETTLED PRODUCTION \_\_\_\_\_ STARTED PRODUCTION \_\_\_\_\_

DATE TUBED \_\_\_\_\_ SYPHON SET \_\_\_\_\_ SIZE \_\_\_\_\_ FEET \_\_\_\_\_

### CASING RECORD

SIZE	WEIGHT	PUT IN WELL		PULLED OUT		LEFT IN WELL		SHOES		PACKERS		
		FEET	IN.	FEET	IN.	FEET	IN.	LENGTH	MAKE	KIND	LENGTH	SET AT
8 5/8	24#	321			None							

LINER: STATE SIZE AND WEIGHT \_\_\_\_\_ WHERE SET \_\_\_\_\_ FT. AND INS. BLANK \_\_\_\_\_ FT. AND INS. PERFORATED \_\_\_\_\_  
 HOW PUT TOGETHER \_\_\_\_\_ COUPLING \_\_\_\_\_ FLUSH-JOINT \_\_\_\_\_ INSERTED \_\_\_\_\_  
 REMARKS \_\_\_\_\_

### EQUIPMENT RECORD

TUBING				SUCKER RODS			PUMPING OUTFIT
SIZE	WEIGHT	FEET	IN.	FEET	IN.	SIZE AND KIND	DESCRIPTION, KIND, SIZE, ETC.

KIND OF SHOT \_\_\_\_\_ SIZE OF SHOT QUARTS \_\_\_\_\_ NUMBER OF SHOTS \_\_\_\_\_  
 NUMBER OF SHELLS \_\_\_\_\_ SIZE OF SHELLS \_\_\_\_\_ INCHES, DIAMETER \_\_\_\_\_  
 LENGTH OF SHELLS \_\_\_\_\_ FT. \_\_\_\_\_ INS. SHOT FURNISHED BY \_\_\_\_\_ TOP OF SHOT \_\_\_\_\_  
 BOTTOM OF SHOT \_\_\_\_\_ ANCHOR \_\_\_\_\_ WELL BRIDGED TO \_\_\_\_\_  
 PRODUCTION BEFORE SHOT \_\_\_\_\_ PRODUCTION AFTER SHOT \_\_\_\_\_  
 NAME OF SHOOTER \_\_\_\_\_ SHOT INSPECTED \_\_\_\_\_ BY \_\_\_\_\_ (COMPANY EMPLOYEE)  
 COMMENCED DRILLING DEEPER \_\_\_\_\_ COMPLETED DRILLING DEEPER \_\_\_\_\_  
 TOTAL DEPTH \_\_\_\_\_ PRODUCTION FIRST 24 HOURS \_\_\_\_\_ SETTLED PRODUCTION \_\_\_\_\_

REMARKS: Completed as dry hole and plugged

**PLUGGING**

MLK SEC 18 T 1 R 31W

BOOK PAGE 28 LINE 41

NOTE: IF WELL WAS DRY, STATE UNDER REMARKS, WHEN, HOW, AND BY WHOM PLUGGED. STATE UNDER REMARKS ANYTHING OF INTEREST NOT COVERED IN LOG. IF SPACE PROVIDED FOR REMARKS IS NOT SUFFICIENT WRITE ON BOTTOM OF LAST SHEET OF LOG.