


STATE OF KANSAS
STATE CORPORATION COMMISSION

Give All Information Completely
Make Required Affidavit
Mail or Deliver Report to:
Conservation Division
State Corporation Commission
800 Bitting Building
Wichita, Kansas

WELL PLUGGING RECORD
15-153-00029-00-01

Rawlins County, Sec. 18 Twp. 1 S Rge. 31 W (E) (W)
Location as "NE/CNW/SW" or footage from lines Center NW/4 of SE/4
Lease Owner Columbian Fuel Corporation
Lease Name Elizabeth Solko Well No. 1
Office Address P. O. Drawer 31, Liberal, Kansas
Character of Well (completed as Oil, Gas or Dry Hole) Dry Hole
Date well completed May 25, 1960
Application for plugging filed May 25, 1960
Application for plugging approved May 25, by A. D. Fabricius 1960
Plugging commenced May 25, 1960
Plugging completed May 25, 1960
Reason for abandonment of well or producing formation Dry Hole

NORTH

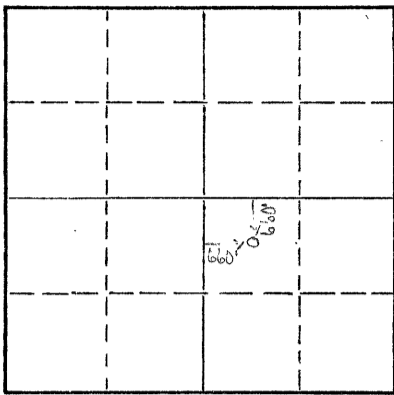

Locate well correctly on above Section Plat

If a producing well is abandoned, date of last production 19
Was permission obtained from the Conservation Division or its agents before plugging was commenced? Yes

Name of Conservation Agent who supervised plugging of this well A. D. Fabricius, Box 731, Hill City, Kansas
Producing formation None Depth to top _____ Bottom _____ Total Depth of Well 4580 Feet
Show depth and thickness of all water, oil and gas formations.

OIL, GAS OR WATER RECORDS

CASING RECORD

| FORMATION | CONTENT | FROM | TO | SIZE | PUT IN | PULLED OUT |
|-----------|---------|------|----|--------|--------|------------|
| | | | | 8-5/8" | 321' | None |
| | | | | | | |
| | | | | | | |
Describe in detail the manner in which the well was plugged, indicating where the mud fluid was placed and the method or methods used in introducing it into the hole. If cement or other plugs were used, state the character of same and depth placed, from _____ feet to _____ feet for each plug set.

| | |
|---------------|------------------------------|
| 4580' to 400' | 9.7 wt. 62 Vis. Drilling Mud |
| 400' to 340' | 20 Sacks Common Cement |
| 340' to 300' | 9.7 wt. 62 Vis. Drilling Mud |
| 300' to 240' | 20 Sacks Common Cement |
| 240' to 40' | 9.7 wt. 62 Vis. Drilling Mud |
| 40' to 0' | 10 Sacks Common Cement |

RECEIVED
STATE CORPORATION COMMISSION
05-27-1960
MAY 27 1960
CONSERVATION DIVISION

(If additional description is necessary, use BACK of this sheet)

Name of Plugging Contractor _____
Address _____

STATE OF Kansas, COUNTY OF Seward, ss.
R. B. Gilliam (employee of owner) or (owner or operator) of the above-described well, being first duly sworn on oath, says: That I have knowledge of the facts, statements, and matters herein contained and the log of the above-described well as filed and that the same are true and correct. So help me God.

(Signature) Robert B. Gilliam
P. O. Drawer 31, Liberal, Kansas
(Address)

SUBSCRIBED AND SWORN TO before me this 26th day of May, 19 60

My commission expires November 5, 1962

Calvin Lindsey
Notary Public.

cc: A. D. Fabricius
R. A. Grady
File

R
COLUMBIAN FUEL CORPORATION

RECEIVED
 STATE CORPORATION COMMISSION
 05-27-1960
 MAY 27 1960

LOG OF WELL

CONSERVATION DIVISION
 Wichita, Kansas

Well Name: Elizabeth Solko
 G. W.: 1152
 Location: Center NW SE Section 18, Township 1-S, Range 31-W, Rawlins
 County, Kansas

15-153-00029-00-01

Date Commenced: October 17, 1954
 Date Completed: October 22, 1954
 Contractor: Midwestern Drillers
 Production: Dry Hole

| | | |
|------|------|-----------------------|
| 0 | 120 | Sand and shale |
| 120 | 204 | Sand and gyp |
| 204 | 327 | Gravel and blue shale |
| 327 | 1330 | Shale and clay |
| 1330 | 1420 | Shale |
| 1420 | 1695 | Shale and lime |
| 1695 | 1710 | Sand |
| 1710 | 1950 | Lime and shale |
| 1950 | 2300 | Sandy shale |
| 2300 | 2310 | Shale |
| 2310 | 2520 | Shale and lime |
| | 2520 | Total Depth |

Casing Record
 8-5/8" 321' 200 Sacks Cement

Date Deepening Commenced: May 12, 1960
 Date Deepening Completed: May 25, 1960
 Contractor: John O. Farmer, Inc., Russell, Kansas
 Production: Dry Hole

| | | |
|------|-----------|--|
| 2520 | 2720 | Red bed and shale |
| 2720 | 2743 | Shale |
| 2743 | 2780 | Anhydrite |
| 2780 | 2830 | Shale and shells |
| 2830 | 3030 | Shale and shells |
| 3030 | 3175 | Shale and shells with some lime streaks |
| 3175 | 3350 | Shale and shells |
| 3350 | 4056 | Shale and lime |
| 4056 | 4170 | Lime |
| 4170 | 4580T. D. | Lime and shale |