

15-153-30029-00-00

STATE OF KANSAS
STATE CORPORATION COMMISSION

Form CP-4


WELL PLUGGING RECORD

Give All Information Completely
Make Required Affidavit
Mail or Deliver Report to:
Conservation Division
State Corporation Commission
212 No. Market
Wichita, Kansas

Rawlins County, Sec. 1 Twp. 1 Rge. 33 ~~XXXX~~(W)

Location as "NE/CNW/SW" or footage from lines C SW NE
Lease Owner Empire Drilling Company
Lease Name Davis Well No. 1
Office Address 650 4th Natl. Bank Bldg., Wichita, Kansas 67202
Character of Well (completed as Oil, Gas or Dry Hole) Dry Hole
Date well completed October 28 19.66
Application for plugging filed October 28 19.66
Application for plugging approved October 28 19.66
Plugging commenced October 28 19.66
Plugging completed October 28 19.66
Reason for abandonment of well or producing formation Dry Hole

NORTH

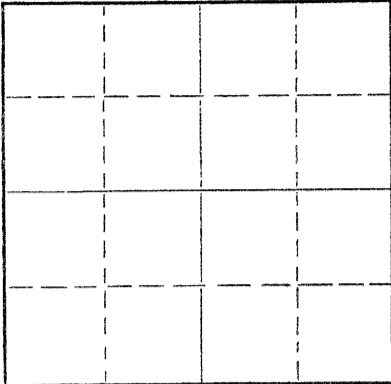

Locate well correctly on above
Section Plat

If a producing well is abandoned, date of last production 19
Was permission obtained from the Conservation Division or its agents before plugging was commenced? yes

Name of Conservation Agent who supervised plugging of this well W. L. Nichols, Morland, Kansas
Producing formation _____ Depth to top _____ Bottom _____ Total Depth of Well 4020 Feet
Show depth and thickness of all water, oil and gas formations.

OIL, GAS OR WATER RECORDS

CASING RECORD

FORMATION	CONTENT	FROM	TO	SIZE	PUT IN	PULLED OUT
Surface	Shale-Bentonite	0	1375	8 5/8"	213'	-0-

Describe in detail the manner in which the well was plugged, indicating where the mud fluid was placed and the method or methods used in introducing it into the hole. If cement or other plugs were used, state the character of same and depth placed, from _____ feet to _____ feet for each plug set.

Plug set at 600' with 20 sacks cement.
Plug set at 150' with 20 sacks cement.
Plug set at 40' with 10 sacks cement.

RECEIVED
STATE CORPORATION COMMISSION
NOV 15 1966
CONSERVATION DIVISION
Wichita, Kansas

(If additional description is necessary, use BACK of this sheet)
Name of Plugging Contractor Empire Drilling Company
Address 650 4th Natl. Bank Bldg., Wichita, Kansas 67202

11-15-1966

STATE OF KANSAS, COUNTY OF SEDGWICK, ss.
Dan J. Kornfeld

(owner or operator) of the above-described well, being first duly sworn on oath, says: That I have knowledge of the facts, statements, and matters herein contained and the log of the above-described well as filed and that the same are true and correct. So help me God.

(Signature) Dan J. Kornfeld
650 4th Natl. Bank Bldg., Wichita, Kansas 67202
(Address)

SUBSCRIBED AND SWORN TO before me this 3rd day of November, 19 66

Sandra Kay Peer
Sandra Kay Peer
Notary Public.

My commission expires September 14, 1968.

LOG

15-153-30029-00-00

COMPANY: Empire Drilling Company
 CONTRACTOR: Empire Drilling Company
 FARM: Davis #1
 LOCATION: C SW NE Section 1-1-33W, Rawlins County, Kansas
 COMMENCED: October 20, 1966 ELEVATION: 2844 KB
 COMPLETED: October 28, 1966 POTENTIAL: D & A

0	to	130	Surface-Shale
130	to	1375	Shale & Bentonite
1375	to	1870	Shale-Shells-Sand
1870	to	2440	Shale & Gypsum
2440	to	2460	Baline Gypsum
2460	to	2665	Shale - Redbed
2665	to	2703	Anhydrite
2703	to	2815	Shale
2815	to	3765	Lime & Shale
3765	to	4020	Lime
4020			Rotary Total Depth

SET: 213' of 8 5/8" with 100 sacks cement.

SAMPLE LOG TOPS:

Anhydrite	2665	+179
Base Anhydrite	2703	+141
Wabaunsee	3430	-586
Topeka	3581	-737
Deer Creek	3621	-777
Oread	3707	-863
Douglas Sand	3748	-904
Lansing	3773	-929
Zone 2A	3824	-980
Zone 5	3862	-1018
Zone 6A	3924	-1080
Zone 7	3966	-1122
Zone 9	4005	-1161
Total Depth	4020	-1176

RECEIVED
 STATE CORPORATION COMMISSION
 NOV 15 1966
 11-15-1966
 CONSERVATION DIVISION
 Topeka, Kansas

C E R T I F I C A T I O N

I, Theodore Gore, do hereby certify that the above and foregoing is a true and correct copy of the log on the Davis #1, C SW NE Section 1-1-33W, Rawlins County, Kansas, as reflected by the files of Empire Drilling Company.

Theodore Gore

 Theodore Gore

Subscribed and sworn to before me, a Notary Public, within and for Sedgwick County, Kansas, this 8th day of November, 1966.

Sandra Kay Peer

 Sandra Kay Peer, Notary Public

My commission expires September 14, 1966.