


STATE OF KANSAS
STATE CORPORATION COMMISSION

WELL PLUGGING RECORD

Give All Information Completely
Make Required Affidavit
Mail or Deliver Report to:
Conservation Division
State Corporation Commission
211 No. Broadway
Wichita, Kansas

Rawlins County, Sec. 3 Twp. 1 Rge. 31 (E) (W)
Location as "NE/CNW/SW" or footage from lines NE NE NW

Lease Owner Oxford Exploration Company
Lease Name Rather Well No. ~~3-13~~ 3-31
Office Address 1550 Denver Club Bldg., Denver, CO 80202
Character of Well (completed as Oil, Gas or Dry Hole) Dry hole
Date well completed 1-27 19 81
Application for plugging filed 1-27 19 81
Application for plugging approved 1-27 19 81
Plugging commenced 1-27 19 81
Plugging completed 1-27 19 81
Reason for abandonment of well or producing formation Dry hole

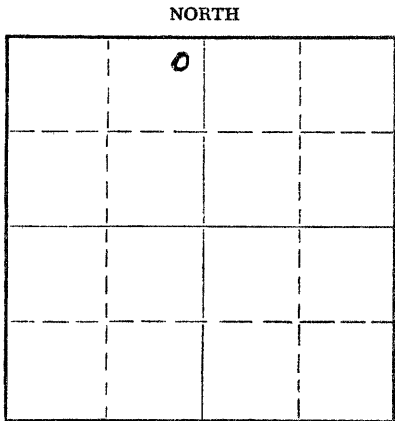

Locate well correctly on above Section Plat

If a producing well is abandoned, date of last production 19
Was permission obtained from the Conservation Division or its agents before plugging was commenced? yes

Name of Conservation Agent who supervised plugging of this well Balthazor
Producing formation none Depth to top Bottom Total Depth of Well Feet
Show depth and thickness of all water, oil and gas formations.

OIL, GAS OR WATER RECORDS

CASING RECORD

FORMATION	CONTENT	FROM	TO	SIZE	PUT IN	PULLED OUT
Ogallala	water	0	550	8 5/8	248	0

Describe in detail the manner in which the well was plugged, indicating where the mud fluid was placed and the method or methods used in introducing it into the hole. If cement or other plugs were used, state the character of same and depth placed, from feet to feet for each plug set.

30 sx 1940 - 1850
30 sx 240 - 150
10 sx 40 - 0
5 sx R.H.

Hole filled with mud by displacement

RECEIVED
STATE CORPORATION COMMISSION

APR 23 1981

4-23-81
CONSERVATION DIVISION
Wichita, Kansas

(If additional description is necessary, use BACK of this sheet)


Name of Plugging Contractor Halliburton
Address

STATE OF Nebraska, COUNTY OF Red Willow, ss.
G. P. Stoepelwerth, II Agent

(employee of owner) or (owner or operator) of the above-described well, being first duly sworn on oath, says: That I have knowledge of the facts, statements, and matters herein contained and the log of the above-described well as filed and that the same are true and correct. So help me God.

(Signature) *G. P. Stoepelwerth*
2005 Norris, McCook, NE 69001 (Address)

SUBSCRIBED AND SWORN TO before me this 10 day of APRIL, 19 81

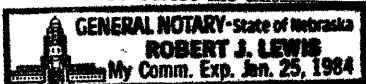

My commission expires

Robert J. Lewis

Notary Public.