

CARD MUST BE TYPED

State of Kansas

CARD MUST BE SIGNED

NOTICE OF INTENTION TO DRILL

(see rules on reverse side)

Expected Spud Date..... 1 15 88
month day year

API Number 15— 153-20,704-00-00 East

OPERATOR: License # 9325
Name Allied Oil
Address Rt 2, Box 45A
City/State/Zip Taneyville, Mo. 65759
Contact Person Roy Grant
Phone 417-546-5885

NW NE SE Sec. 8 Twp. 1 S, Rg 33 X West
2310 Ft. from South Line of Section
990 Ft. from East Line of Section

(Note: Locate well on Section Plat on reverse side)

CONTRACTOR: License # 8682
Name Golden Eagle Drilling, Inc.
City/State McCook, Nebraska 69001

Nearest lease or unit boundary line ~~990~~ 330 feet
County Rawlins
Lease Name Vap Well # 1

Well Drilled For: Well Class: Type Equipment:
 Oil Storage Infield Mud Rotary
 Gas Inj Pool Ext. Air Rotary
 OWWO Expl Wildcat Cable

Ground surface elevation 3011 feet MSL
Domestic well within 330 feet: yes no
Municipal well within one mile: yes no

If OWWO: old well info as follows:
Operator
Well Name
Comp Date Old Total Depth.....

Depth to bottom of fresh water... 200
Depth to bottom of usable water 250-200
Surface pipe by Alternate: 1X 2
Surface pipe planned to be set... 300
Conductor pipe required
Projected Total Depth... 4270 feet
Formation... LKC

I certify that well will comply with K.S.A. 55-101, et seq., plus eventually plugging hole to KCC specifications.
Date 12-23-87 Signature of Operator or Agent [Signature] Title Agent

For KCC Use:
Conductor Pipe Required feet; Minimum Surface Pipe Required 250 feet per Alt. 1
This Authorization Expires... 6-30-88 Approved By PCA-12-30-87


EFFECTIVE DATE: 1-4-88

Must be filed with the K.C.C. five (5) days prior to commencing well
 This card void if drilling not started within six (6) months of date received by K.C.C.

Important procedures to follow:

1. Notify District office before setting surface casing.
2. Set surface casing by circulating cement to the top.
3. File completion forms ACO-1 with K.C.C. within 120 days of well spud date, following instructions on ACO-1, side 1, and including copies of wireline logs.
4. Notify District office 48 hours prior to old well workover or re-entry.
5. Prior to filing Intent, prepare a proposed plugging plan in case well is D & A, then obtain approval of plan when calling district office prior to setting surface pipe.
6. Submit plugging report (CP-4) to K.C.C. after plugging is completed.
7. Obtain an approved injection docket number before disposing of salt water.
8. Notify K.C.C. within 10 days when injection commences or terminates.

**A Regular Section of Land
 1 Mile = 5,280 Ft.**

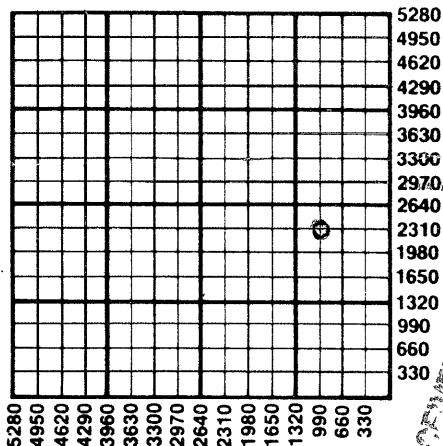

STATE RECEIVED
 12-28-87
 DEC 29 1987
 CONSERVATION DIVISION
 Wichita, Kansas

an alternate 2 completion, cement in the production pipe from below any usable water to surface within 120 days of spud date.

State Corporation Commission of Kansas
 Conservation Division
 200 Colorado Derby Building
 Wichita, Kansas 67202-1212
 (316) 263-3238