


WELL PLUGGING RECORD

Give All Information Completely  
Make Required Affidavit  
Mail or Deliver Report to:  
Conservation Division  
State Corporation Commission  
211 No. Broadway  
Wichita, Kansas

NORTH

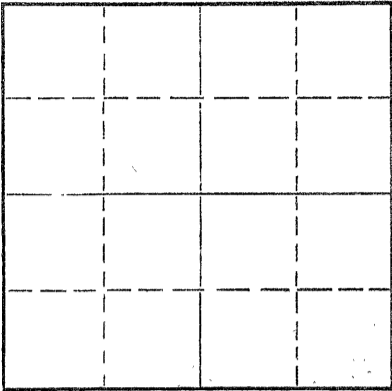

Locate well correctly on above  
Section Plat

Rawlins County, Sec. 8 Twp. 1s Rge. 33 (W)  
Location as "NE/CNW%SW%" or footage from lines C NW NE  
Lease Owner Leben Drilling, Inc.  
Lease Name Peterson Well No. 1  
Office Address P.O. Box 486 Great Bend, Kansas  
Character of Well (completed as Oil, Gas or Dry Hole) Dry Hole  
Date well completed 7-6-61 19\_\_  
Application for plugging filed 7-6-61 19\_\_  
Application for plugging approved 7-6-61 19\_\_  
Plugging commenced 7-6-61 19\_\_  
Plugging completed 7-6-61 19\_\_  
Reason for abandonment of well or producing formation Dry Hole

If a producing well is abandoned, date of last production \_\_\_\_\_ 19\_\_  
Was permission obtained from the Conservation Division or its agents before plugging was commenced? Yes

Name of Conservation Agent who supervised plugging of this well Eldon Petty  
Producing formation \_\_\_\_\_ Depth to top \_\_\_\_\_ Bottom \_\_\_\_\_ Total Depth of Well 4680' Feet  
Show depth and thickness of all water, oil and gas formations.

OIL, GAS OR WATER RECORDS

CASING RECORD

FORMATION	CONTENT	FROM	TO	SIZE	PUT IN	PULLED OUT
				8 5/8"	231'	

Describe in detail the manner in which the well was plugged, indicating where the mud fluid was placed and the method or methods used in introducing it into the hole. If cement or other plugs were used, state the character of same and depth placed, from \_\_\_\_\_ feet to \_\_\_\_\_ feet for each plug set.

1st Plug @ 600' w/20 sks cement  
2nd Plug @ 180' w/20 sks cement  
3rd Plug @ 40' w/10 sks cement

RECEIVED  
STATE CORPORATION COMMISSION

JUL 13 1961

CONSERVATION DIVISION  
Wichita, Kansas

7-13-61

(If additional description is necessary, use BACK of this sheet)

Name of Plugging Contractor Leben Drilling, Inc.  
Address P.O. Box 486 Great Bend, Kansas

STATE OF Kansas, COUNTY OF Barton, ss.  
Byron Johnson (employee of owner) or (owner or operator) of the above-described well, being first duly sworn on oath, says: That I have knowledge of the facts, statements, and matters herein contained and the log of the above-described well as filed and that the same are true and correct. So help me God.

(Signature) Byron Johnson  
Byron Johnson  
P.O. Box 486 Great Bend, Kansas (Address)

SUBSCRIBED AND SWORN TO before me this 12 day of July, 19 61

My commission expires April 1, 1963

Ulanda Nichols  
Ulanda Nichols  
Notary Public.



LOG

COMPANY:  
CONTRACTOR:  
FIRM:  
LOCATION:  
  
COMMENCED:  
COMPLETED:

LEBAN DRILLING, INC.  
LEBAN DRILLING, INC.  
PETERSON # 1  
C NW NE SW, S-18-T3W  
RAWLINS COUNTY, KANSAS  
6-21-61  
7-5-61

0	70	Shale
70	150	Shale
150	190	Sand
190	215	Clay
215	237	Blue Shale
237	260	Shale
260	900	Shale & Red Bed
900	1180	Sand
1180	1450	Sand & Shale
1450	1850	Shale
1850	2022	Shale & Shells
2022	2235	Sand & Shale
2235	2335	Sand & Shale
2335	2475	Sand & Shale
2475	2590	Lime & Shale
2590	2805	Lime & Shale
2805	2910	Lime & Shale
2910	3098	Shale & Lime
3098	3159	Lime & Shale
3159	3167	Shale
3167	3235	Lime & Shale
3235	3385	Lime & Shale
3385	3513	Lime & Shale
3513	3610	Lime
3610	3755	Lime
3755	3825	Lime
3825	3900	Lime & Shale
3900	3945	Lime & Shale
3945	3975	Lime
3975	4010	Lime
4010	4060	Lime
4060	4120	Lime
4120	4150	Lime
4150	4191	Lime
4191	4260	Lime
4260	4350	Lime
4350	4395	Lime
4395	4464	Lime
4464	4540	Lime
4540	4610	Cherty Conglomerate
4610	4622	Cherty Conglomerate
4622	4662	Conglomerate & Archaic
4662	4680	Archaic
	4680	Rotary Total Depth - D & A

RECEIVED  
STATE CORPORATION COMMISSION  
JUL 13 1961  
CONSERVATION DIVISION  
Wichita, Kansas  
7-13-61

Set 8 5/8" surface casing @ 237' with 175 cc burst cement.

I, Byron Johnson, do hereby certify that the above and foregoing is a true and correct copy of the log of the Peterson #1, located C NW NE of Sec. 8, Township 1 South, Range 33 West, Rawlins County, Kansas, as reflected by the files of Leban Drilling, Inc.

*Byron Johnson*  
Byron Johnson

STATE OF KANSAS )  
COUNTY OF RAWLINS )

Subscribed and sworn to before me, a Notary Public, in and for Rawlins County, Kansas, this 11th day of July, 1961.

My Commission Expires:  
April 1, 1963

Glenda Nichols, Notary Public