


WELL PLUGGING RECORD

Give All Information Completely
Make Required Affidavit
Mail or Deliver Report to:
Conservation Division
State Corporation Commission
212 No. Market
Wichita, Kansas

NORTH

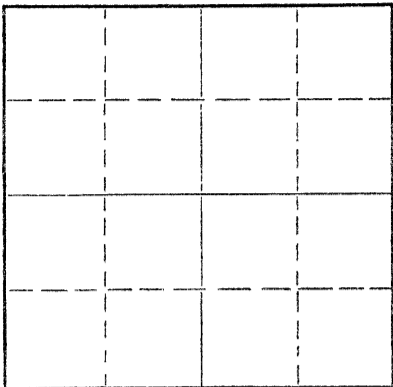

Locate well correctly on above
Section Plat

Rawlins County. Sec. 7 Twp. 1 Rge. 33 (~~XXXX~~) (W)
Location as "NE/CNW&SW&W" or footage from lines. C W/2 W/2 NE
Lease Owner Empire Drilling Company
Lease Name R. H. Palmer Well No. 2
Office Address 650 4th Natl. Bank Bldg., Wichita, Kansas 67202
Character of Well (completed as Oil, Gas or Dry Hole) Dry Hole
Date well completed May 4 19 67
Application for plugging filed May 4 19 67
Application for plugging approved May 4 19 67
Plugging commenced May 4 19 67
Plugging completed May 4 19 67
Reason for abandonment of well or producing formation Dry Hole

If a producing well is abandoned, date of last production _____ 19____
Was permission obtained from the Conservation Division or its agents before plugging was commenced? yes W. L. Nichols, Morland, Kansas

Name of Conservation Agent who supervised plugging of this well W. L. Nichols, Morland, Kansas
Producing formation _____ Depth to top _____ Bottom _____ Total Depth of Well 4200 Feet
Show depth and thickness of all water, oil and gas formations.

OIL, GAS OR WATER RECORDS

CASING RECORD

FORMATION	CONTENT	FROM	TO	SIZE	PUT IN	PULLED OUT
	Surface - Shale	0	400	8 5/8"	204'	-0-

Describe in detail the manner in which the well was plugged, indicating where the mud fluid was placed and the method or methods used in introducing it into the hole. If cement or other plugs were used, state the character of same and depth placed, from _____ feet to _____ feet for each plug set.

Plug set at 600' with 20 sacks cement.
Plug set at 210' with 20 sacks cement.
Plug set at 40' with 10 sacks cement.

RECEIVED
STATE CORPORATION COMMISSION
MAY 22 1967
CONSERVATION DIVISION
Wichita, Kansas

(If additional description is necessary, use BACK of this sheet)
Name of Plugging Contractor Empire Drilling Company 5-22-67
Address 650 4th Natl. Bank Bldg., Wichita, Kansas 67202

STATE OF KANSAS, COUNTY OF SEDGWICK, ss.
Dan J. Kornfeld (employee of owner) or (owner or operator) of the above-described well, being first duly sworn on oath, says: That I have knowledge of the facts, statements, and matters herein contained and the log of the above-described well as filed and that the same are true and correct. So help me God.

(Signature) [Signature]
Dan J. Kornfeld
650 4th Natl. Bank Bldg. Wichita, Kansas 67202
(Address)

SUBSCRIBED AND SWORN TO before me this 15th day of May, 19 67

My commission expires September 14, 1968

[Signature]
Sandra Kay Peer
Notary Public.

LOG

COMPANY: Empire Drilling Company
 CONTRACTOR: Empire Drilling Company
 FARM: R. H. Palmer #2
 LOCATION: Approx. C W/2 W/2 NE Section 7-1-33W, Rawlins County, Kansas
 COMMENCED: April 25, 1967
 COMPLETED: May 4, 1967

15-153-20009-00-00
 ELEVATION: 3024 KB
 POTENTIAL: D & A

0	to	400	Surface-Shale
400	to	1700	Shale
1700	to	2150	Shale & Sand
2150	to	2310	Shale
2310	to	2658	Shale & Gypsum
2658	to	2672	Blaine Gypsum
2672	to	2867	Redbed
2867	to	2901	Anhydrite
2901	to	3140	Shale
3140	to	3280	Shale & Lime
3280	to	3612	Lime
3612	to	3760	Shale & Lime
3760	to	4200	Lime
4200			Rotary Total Depth

SET: 204' of 8 5/8" with 100 sacks cement.


SCHLUMBERGER ELECTRIC LOG TOPS:

Anhydrite	2866	+158
Base Anhydrite	2899	+125
Topeka	3723	-699
Deer Creek	3774	-750
Oread	3838	-814
Base Leavenworth	3885	-861
Douglas Sand	3890	-866
Lansing	3926	-902
Sandy Zone	3947	-923
Base Kansas City	4183	-1159
Total Depth	4199	-1175

RECEIVED
 STATE CORPORATION COMMISSION
 MAY 22 1967
 5-22-67
 CONSERVATION DIVISION
 Wichita, Kansas

C E R T I F I C A T I O N

I, Dan J. Kornfeld, do hereby certify that the above and foregoing is a true and correct copy of the log on the R. H. Palmer #2, Approx. C W/2 W/2 NE Section 7-1-33W, Rawlins County, Kansas, as reflected by the files of Empire Drilling Company.

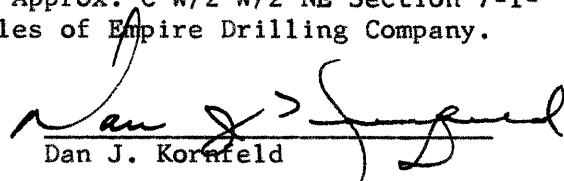
 Dan J. Kornfeld

Subscribed and sworn to before me, a Notary Public, within and for Sedgwick County, Kansas, this 15th day of May, 1967.

My commission expires September 14, 1968


 Sandra Kay Peer, Notary Public