

KANSAS

WELL COMPLETION REPORT AND
DRILLER'S LOG

15-153-20377-00-00

API No. 15 — 153 — 20,377
County Number

Operator
William E. Wise

Address
46B Denver Tech-Center Englewood, Colo 80111

Well No. #1 Lease Name Meyer

Footage Location
660 feet from (X) (S) line 2080 feet from (E) (XX) line

Principal Contractor Prairie Drilling Co. Geologist Joe Bato

Spud Date May 15, 1980 Date Completed May 26, 1980 Total Depth 4288 P.B.T.D. Surface


Directional Deviation _____ Oil and/or Gas Purchaser _____

S. 19 T. 1 R. 32 E. W

Loc. 100' W/C SW SE

County Rawlins

640 Acres
N

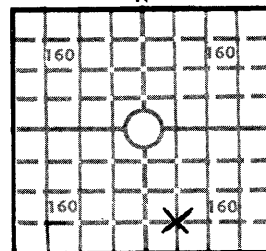

Locate well correctly

Elev.: Gr. 3002

DF 3012 KB 3013

CASING RECORD

Report of all strings set — surface, intermediate, production, etc.

Purpose of string	Size hole drilled	Size casing set (in O.D.)	Weight lbs/ft.	Setting depth	Type cement	Sacks	Type and percent additives
Surface	12 1/4	8 5/8	24	339	60/40 Pozmix	225	3% Ca Cl2

LINER RECORD

PERFORATION RECORD

Top, ft.	Bottom, ft.	Sacks cement	Shots per ft.	Size & type	Depth interval

TUBING RECORD

Size	Setting depth	Packer set at

ACID, FRACTURE, SHOT, CEMENT SQUEEZE RECORD

Amount and kind of material used	Depth interval treated

INITIAL PRODUCTION

Date of first production	Producing method (flowing, pumping, gas lift, etc.)				
RATE OF PRODUCTION PER 24 HOURS	Oil	Gas	Water	Gas-oil ratio	CFPB
	bbls.	MCF	bbls.		
Disposition of gas (vented, used on lease or sold)			Producing interval (s)		

RECEIVED
JUN - 4 1980 6-4-1980

INSTRUCTIONS: As provided in KCC Rule 82-2-125, within 90 days after completion of a well, one completed copy of this Drillers Log shall be transmitted to the State Geological Survey of Kansas, 4150 Monroe Street, Wichita, Kansas 67209. Copies of this form are available from the Conservation Division, State Corporation Commission, 245 No. Water, Wichita, Kansas 67202. Phone AC 316-522-2206. If confidential custody is desired, please note Rule 82-2-125. Drillers Logs will be on open file in the Oil and Gas Division, State Geological Survey of Kansas, Lawrence, Kansas 66044.

Operator William E. Wise DESIGNATE TYPE OF COMP.: OIL, GAS, DRY HOLE, SWDW, ETC.:

Well No. 1 Lease Name Meyer Dry Hole


S 19 T 1 S R 32 W

WELL LOG
 Show all important zones of porosity and contents thereof; cored intervals, and all drill-stem tests, including depth interval tested, cushion used, time tool open, flowing and shut-in pressures, and recoveries. SHOW GEOLOGICAL MARKERS, LOGS RUN, OR OTHER DESCRIPTIVE INFORMATION.

FORMATION DESCRIPTION, CONTENTS, ETC.	TOP	BOTTOM	NAME	DEPTH
Smokey Hill chalk	970	1368	Gamma Ray	4273 - Surf
Ft. Hays limestone	1368	1470	Neutron	4281 - Surf
Greenhorn limestone	1664	1770	Guard	4277 - 3300
Dakota sandstone	1810	2100	Caliper	4271 - 3300
Cedar Hills sandstone	2630	2695		
Anhydrite	2830	2870		
Oread limestone	3873	3912		
Douglas sandstone	3960	3970		
Top Lansing limestone	3981	4238		
DST 4035 - 4102 Open 15, shut in 30, Open 20, shut in 60 Recovered 10' mud with oil scum HP 3020-3041 IFP 62-62 FFP 62-62 SIP 785-703				

USE ADDITIONAL SHEETS, IF NECESSARY, TO COMPLETE WELL RECORD.

Date Received _____

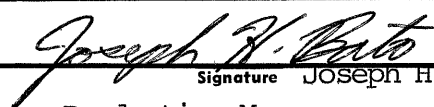
 Signature Joseph H. Bato
 Production Manager
 Title
 June 2, 1980
 Date