


15-153-20377-00-00

STATE OF KANSAS
STATE CORPORATION COMMISSION

WELL PLUGGING RECORD

Give All Information Completely
Make Required Affidavit
Mail or Deliver Report to
Conservation Division
State Corporation Comm.
245 North Water
Wichita, KS 67202

Rawlins County. Sec. 19 Twp. 1S Rge. 32 ~~NE~~W
Location as "NE/CNW $\frac{1}{4}$ SW $\frac{1}{4}$ " or footage from lines
100' W/c SW SE
Lease Owner William E. Wise
Lease Name Meyer Well No. 1
Office Address 46B Denver Tech Center, Englewood, Co. 80111
Character of Well (Completed as Oil, Gas or Dry Hole)
Dry Hole
Date Well completed May 26 1980
Application for plugging filed June 2 1980
Application for plugging approved 19
Plugging commenced May 26 1980
Plugging completed May 26 1980
Reason for abandonment of well or producing formation
Non productive
If a producing well is abandoned, date of last production
19

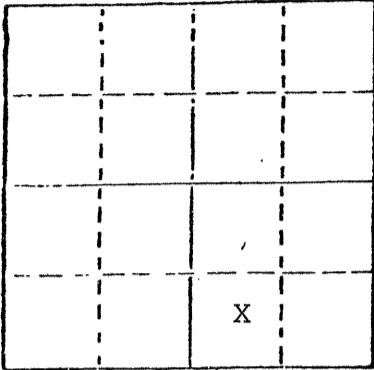

Locate well correctly on above Section Plat

Was permission obtained from the Conservation Division or its agents before plugging was commenced? Yes
Name of Conservation Agent who supervised plugging of this well Marion Schmidt
Producing formation None Depth to top Bottom Total Depth of Well 4288
Show depth and thickness of all water, oil and gas formations.

OIL, GAS OR WATER RECORDS

CASING RECORD

FORMATION	CONTENT	FROM	TO	SIZE	PUT IN	PULLED OUT
Dakota 1810'	Water	Surface	339	8 5/8	328	None

Describe in detail the manner in which the well was plugged, indicating where the mud fluid was placed and the method or methods used in introducing it into the hold. If cement or other plugs were used, state the character of same and depth placed, from _____ feet to _____ feet for each plug set.

- 60 sacks 50/50 Pozmix 6% gel, 1860' to 1600' Pump truck
- 30 sacks 50/50 Pozmix 6% gel, 330' to 200' Pump truck
- 10 sacks 50/50 Pozmix 6% gel, 40' to Surface, Pump truck
- 1 sack Cottonseed Hulls and Rubber Plug set at 40' Pushed down with Kelly
- Intervening intervals, filled with 9.5 lb/gal mud
- 3 sacks in Rat hole,
- 2 sacks in Mouse hole.

(If additional description is necessary, use BACK of this sheet)

Name of Plugging Contractor Halliburton Services

STATE OF Colorado COUNTY OF Arapahoe, ss.
Joseph H. Bato (employee of owner) or (owner or operator)
of the above-described well, being first duly sworn on oath, says: That I have knowledge of the facts, statements, and matters herein contained and the log of the above-described well as filed and that the same are true and correct. So help me God.

(Signature) Joseph H. Bato
46B Denver Tech Center, Englewood, Co. 80111
(Address)

SUBSCRIBED AND SWORN TO before me this 2nd day of June
Joanne C. Roth
Notary Public.

My commission expires My Commission Expires Feb. 21, 1983

RECEIVED
6-4-1980
JUL 1 1980
Wichita, Kansas