

STATE OF KANSAS
STATE CORPORATION COMMISSION


15-153-20119-00-01

WELL PLUGGING RECORD Washdown

Give All Information Completely
Make Required Affidavit
Mail or Deliver Report to
Conservation Division
State Corporation Comm.
245 North Water
Wichita, KS 67202

Rawlins County, Sec. 19 Twp. 1S Rge. 32 ~~NE~~W
Location as "NE/CNW $\frac{1}{4}$ SW $\frac{1}{4}$ " or footage from lines
C NE NE

Lease Owner Kern Co.
Lease Name WICKE "D" Well No. 1
Office Address 250 Mid America Bldg., Midland TX 79701
Character of Well (Completed as Oil, Gas or Dry Hole)
Dry Hole

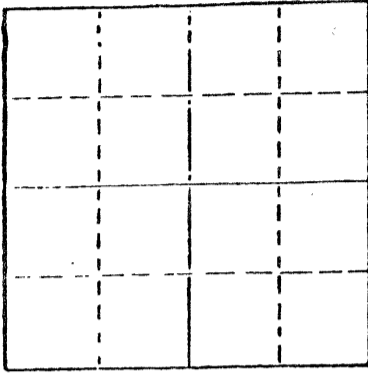

Date Well completed March 13 1979
Application for plugging filed March 13 1979
Application for plugging approved March 13 1979
Plugging commenced March 13 1979
Plugging completed March 13 1979
Reason for abandonment of well or producing formation
D&A

If a producing well is abandoned, date of last production
19

Was permission obtained from the Conservation Division or
its agents before plugging was commenced? yes

Name of Conservation Agent who supervised plugging of this well Gilbert Balthazor
Producing formation Depth to top Bottom Total Depth of Well 4145'
Show depth and thickness of all water, oil and gas formations.

OIL, GAS OR WATER RECORDS

CASING RECORD

FORMATION	CONTENT	FROM	TO	SIZE	PUT IN	PULLED OUT
				Previous	set	

Describe in detail the manner in which the well was plugged, indicating where the mud fluid was placed and the method or methods used in introducing it into the hold. If cement or other plugs were used, state the character of same and depth placed, from feet to feet for each plug set.

1st plug @ 2025' w/70 sx, 50-50 posmix, 6% gel
2nd plug @ 300' w/20 sx, 50-50 posmix, 6% gel
3rd plug @ 40' w/10 sx, 50-50 posmix, 6% gel
5 sx in rat hole

(If additional description is necessary, use BACK of this sheet)

Name of Plugging Contractor Murfin Drilling Company

STATE OF KANSAS COUNTY OF SEDGWICK, ss.
Wm. S. Shropshire of Murfin Drilling Company (employee of owner) or (owner or operator)
of the above-described well, being first duly sworn on oath, says: That I have knowledge of
the facts, statements, and matters herein contained and the log of the above-described well
as filed and that the same are true and correct. So help me God.

(Signature) Wm. S. Shropshire
Wm. S. Shropshire, Asst. Gen. Mgr.
617 Union Center, Wichita, KS 67202
(Address)

SUBSCRIBED AND SWORN TO before me this 21st day of March, 19 79

Sandra Kay May
Sandra Kay May Notary Public.

My commission expires 6-5-80

Received
3-15-79

