

15-153-20653-00-00

*Plugged*

CO-7  
(Revised)

PLAT AND CERTIFICATION OF ACREAGE ATTRIBUTABLE TO AN OIL WELL

State Corporation Commission, Conservation Division  
200 Colorado Derby Bldg. Wichita, Kansas 67202

OPERATOR Viking Resources

LOCATION OF WELL:

LEASE Wicke

1980 feet from the North line

WELL NUMBER 2

2310 feet from the West line

FIELD Wilhelm

Of the \_\_\_\_\_ of Sec 16 T. 1 R. 32 W


COUNTY Rawlins

\*NUMBER OF ACRES  
ATTRIBUTABLE TO WELL 20

DESCRIPTION OF ACREAGE:  
E/2 of SE/4 of NW/4

P L A T

(Show location of Well and outline attributable acreage)

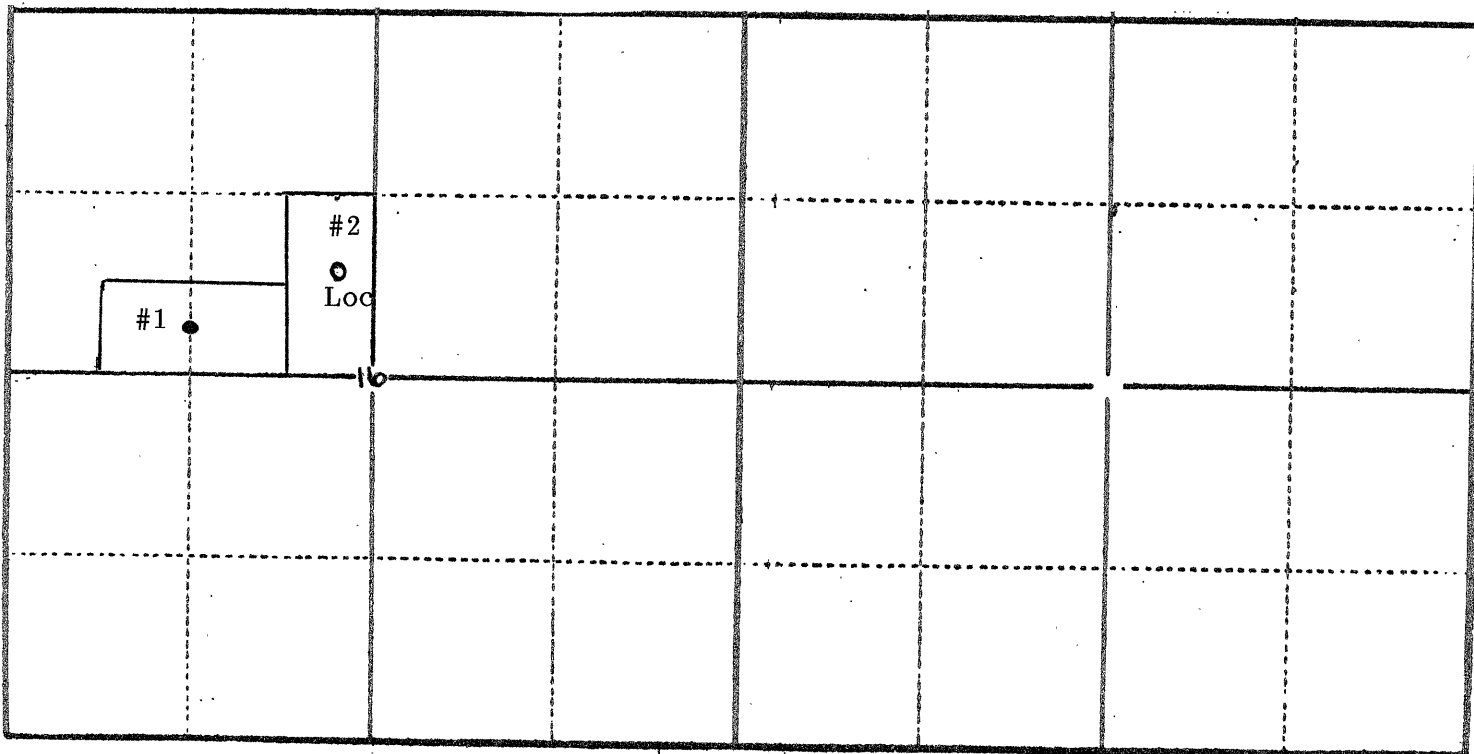

The undersigned hereby certifies that he is a partner  
~~for~~ of Viking Resources, a duly authorized agent, that all information  
shown hereon is true and correct to the best of his knowledge and belief, and that  
all acreage claimed as attributable to the well named herein is held by production  
from that well.

*Thomas Wesselton*

Suscribed and sworn to before me on this 14th day of March, 19 86.

*Paula R. Dunagan*

Notary Public

My Commission expires March 2, 1989



RECEIVED  
STATE CORPORATION COMMISSION

MAR 17 1986

CONSERVATION DIVISION  
Wichita, Kansas

3-17-1986