

STATE OF KANSAS
 STATE CORPORATION COMMISSION
 200 Colorado Derby Bldg.
 Wichita, Kansas 67202


Form CP-4
 Rev. 12-15-80

WELL PLUGGING RECORD

15-153-20418-00-00

Give All Information Completely
 Make Required Affidavit

COUNTY Rawlins SEC. 15 TWP. 1S RGE. 33 NW
 Location as in quarters or footage from lines:
C. SWNW

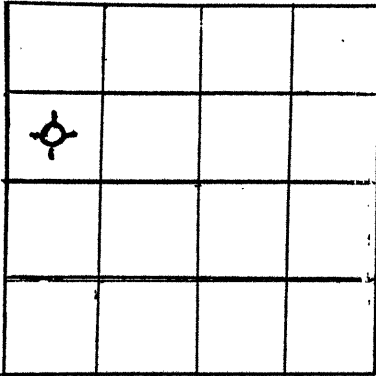

Locate Well
 correctly on above
 Section Platt.

Lease Owner Aspen Exploration Corporation, **et al
 Lease Name Daniel Vap Well No. 1-15
 Office Address #350, 3525 S. Tamarac, Denver, CO 80237
 Character of Well (Completed as Oil, Gas or Dry Hole): Dry hole
 Date Well Completed May 21, 1983
 Application for plugging filed October 26, 1982
 Plugging commenced May 13, 1983
 Plugging completed May 21, 1983
 Reason for abandonment of well or producing formation
Well could not be completed as oil well in Lansing.
 Was permission obtained from the Conservation Division or it's
 Agent's before plugging was commenced? yes

Name of Conservation Agent who supervised plugging of this well Carl Goodrow
 Producing formation Lansing Depth to top 3872 bottom T.D. 4565
 Show depth and thickness of all water, oil and gas formations.

OIL, GAS OR WATER RECORDS

Casing Record

Formation	Content	From	To	Size	Put in	Pulled Out
Lansing-Kansas City	Show Oil	4057	4066	4-1/2	4140	1765
	Show Oil	3921	3928			
Surface casing				8-5/8	573	-0-

Describe in detail the manner in which the well was plugged, indicating where the mud fluid was placed and the method or methods used in introducing it into the hold. If cement or other plugs were used, state the character of same and depth placed, from _____ feet to _____ feet for each plug set.

Haliburton pumped 50 sacks of cement and wiper plug to 3810. Checked by SLM.
Perforated anhydrite at 2775. Shot off casing at 1765 and retrieved it. Halliburton
plugged well with 2 sacks of hulls, 4 sacks gel, 100 sacks cement 50-50 pas
6% gel 370 cc, 36 sacks gel, 70 sacks cement, 50 - 50 pas 6% gel 370 cc. Closed in
pressure 400 lbs.

**Aspen Exploration Corporation, Successor to Jamar Exploration, Inc.

(If additional description is necessary, use BACK of this sheet)

Name of Plugging Contractor POE WELL SERVICE INC.

CITY &
 STATE OF COLORADO COUNTY OF DENVER, ss.

HOWARD W. DENNIS (employee of owner) or (~~owner or operator~~) of the
 above-described well, being first duly sworn on oath, says: That I have knowledge of the
 facts, statements, and matters herein contained and the log of the above-described well as
 filed and that the same are true and correct. So help me God.

(Signature) Howard W. Dennis
644 RACE ST. DENVER, CO 80206
 (Address)

SUBSCRIBED AND SWORN TO before me this 22nd day of June, 19 83

My Commission expires: _____
 MY COMMISSION EXPIRES 3/26/87
 STATE CORPORATION COMMISSION
 Notary Public.

RECEIVED
 JUN 27 1983
 627-83
 CONSERVATION DIVISION
 Wichita, Kansas

B. GAIL KILGOUR, NOTARY PUBLIC
 SUITE 350, 3525 S. TAMARAC
 DENVER, CO 80237