

15-153-20305-00-00

WELL PLUGGING RECORD

Give All Information Completely
Make Required Affidavit
Mail or Deliver Report to:
Conservation Division
State Corporation Commission
211 No. Broadway
Wichita, Kansas

Rawlins County. Sec. 15 Twp. 1S Rge. 33W (E) (W)

Location as "NE/CNW/SW" or footage from lines 200' So. of NW NE

Lease Owner Thunderbird Drilling, Inc.

Lease Name Vap Well No. 1

Office Address P. O. Box 18407 - Wichita, Kansas 67218

Character of Well (completed as Oil, Gas or Dry Hole) Dry Hole

Date well completed 12/20/77 19

Application for plugging filed 12/20/77 19

Application for plugging approved 12/20/77 19


Plugging commenced 12/20/77 19

Plugging completed 12/20/77 19

Reason for abandonment of well or producing formation Dry Hole

If a producing well is abandoned, date of last production 19

Was permission obtained from the Conservation Division or its agents before plugging was commenced? Yes

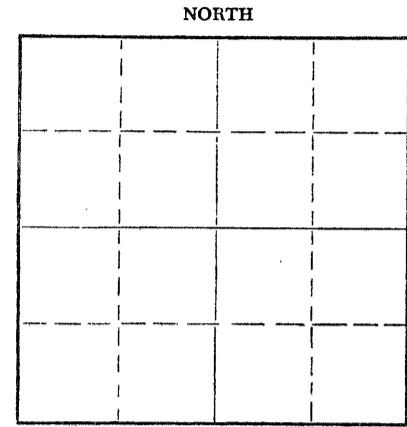

Locate well correctly on above Section Plat

Name of Conservation Agent who supervised plugging of this well Gilbert Balthazor

Producing formation _____ Depth to top _____ Bottom _____ Total Depth of Well 4322 Feet

Show depth and thickness of all water, oil and gas formations.

OIL, GAS OR WATER RECORDS

CASING RECORD

FORMATION	CONTENT	FROM	TO	SIZE	PUT IN	PULLED OUT
	Surface			8 5/8"	332	0

Describe in detail the manner in which the well was plugged, indicating where the mud fluid was placed and the method or methods used in introducing it into the hole. If cement or other plugs were used, state the character of same and depth placed, from _____ feet to _____ feet for each plug set.

1st Plug @ 1800' w/70 sx

2nd Plug @ 300' w/20 sx

3rd Plug @ 40' w/10 sx

RECEIVED
STATE CORPORATION COMMISSION

JAN 03 1978

CONSERVATION DIVISION
Wichita, Kansas

1-3-78

Name of Plugging Contractor Thunderbird Drilling, Inc. (If additional description is necessary, use BACK of this sheet)

Address P. O. Box 18407- Wichita, Kansas 67218

STATE OF KANSAS, COUNTY OF SEDGWICK, ss.

Burke Krueger

(employee of owner) or (owner or operator) of the above-described well, being first duly sworn on oath, says: That I have knowledge of the facts, statements, and matters herein contained and the log of the above-described well as filed and that the same are true and correct. So help me God.

(Signature)

Burke Krueger
P. O. Box 18407- Wichita, Kansas 67218
(Address)

SUBSCRIBED AND SWORN TO before me this 28th day of December, 1977

My commission expires 3-25-80

Gloria DeJesus
Gloria DeJesus

Notary Public.



