


STATE OF KANSAS
STATE CORPORATION COMMISSION

15-153-20282-00-00

Give All Information Completely
Make Required Affidavit
Mail or Deliver Report to:
Conservation Division
State Corporation Commission
212 North Market, Insurance Bldg.
Wichita, Kansas

WELL PLUGGING RECORD

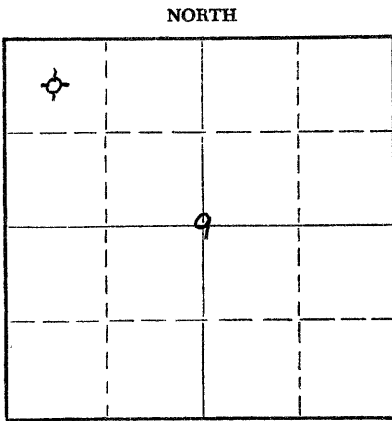

Locate well correctly on above Section Plat

Rawlins County. Sec. 9 Twp. 1S Rge. 33W (E) (W)
Location as "NE/CNW/SW" or footage from lines. C NW NW
Lease Owner John P. Jennings Oil Co.
Lease Name Bucy Well No. 1
Office Address Suite 309, 200 E. First St., Wichita, Ks. 67202
Character of Well (completed as Oil, Gas or Dry Hole) Dry Hole
Date well completed 5-31-77 19
Application for plugging filed Yes 19
Application for plugging approved 19
Plugging commenced 19
Plugging completed 8:30 P.M. 5-31-77 19
Reason for abandonment of well or producing formation

If a producing well is abandoned, date of last production 19
Was permission obtained from the Conservation Division or its agents before plugging was commenced? Yes

Name of Conservation Agent who supervised plugging of this well Gilbert Balthazor
Producing formation Depth to top Bottom Total Depth of Well Feet
Show depth and thickness of all water, oil and gas formations.

OIL, GAS OR WATER RECORDS

CASING RECORD

FORMATION	CONTENT	FROM	TO	SIZE	PUT IN	PULLED OUT

Describe in detail the manner in which the well was plugged, indicating where the mud fluid was placed and the method or methods used in introducing it into the hole. If cement or other plugs were used, state the character of same and depth placed, from feet to feet for each plug set.

Plug #1	1750'	70 sx.
Plug #2	200'	20 sx.
Plug #3	40'	10 sx.


RECORDED
STATE CORPORATION COMMISSION
JUN 09 1977
6-9-77
CONSENT TO PLUG
Wichita, Kansas

(If additional description is necessary, use BACK of this sheet)
Name of Plugging Contractor John O. Farmer, Inc.
Address Box 352, Russell, Kansas 67665

STATE OF KANSAS, COUNTY OF SEDGWICK, ss.
operator (employee of owner) or (owner or operator) of the above-described well, being first duly sworn on oath, says: That I have knowledge of the facts, statements, and matters herein contained and the log of the above-described well as filed and that the same are true and correct. So help me God.

(Signature) John P. Jennings
Suite 309, 200 E. First, Wichita, Ks.
(Address)

Subscribed and Sworn to before me this 6th day of June, 1977

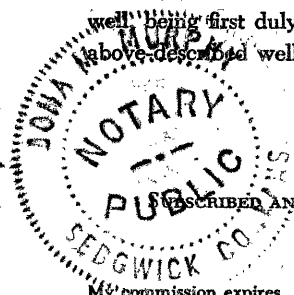

Dona M. Murphy
Dona M. Murphy Notary Public.

My commission expires 8-4-79