

CARD MUST BE TYPED

State of Kansas

CARD MUST BE SIGNED

NOTICE OF INTENTION TO DRILL

(see rules on reverse side)

Starting Date 11/20/86 month day year

API Number 15- 153-20,676-00-00

OPERATOR: License # 8061
Name Oil Producers, Inc. of Kansas
Address P.O. Box 8647
Wichita, Kansas 67208
City/State/Zip
Contact Person John S. Weir
Phone 316-681-0231

C NW NE Sec. 11 Twp. 1S S, Rg. 33 East
..... West
4620 Ft. from South Line of Section
1980 Ft. from East Line of Section

(Note: Locate well on Section Plat on reverse side)

CONTRACTOR: License # 4083
Name Western Kansas Drilling Inc.
City/State Hays, Ks.

Nearest lease or unit boundary line 330 feet
County Rawlins
Lease Name Thomas Well # 1

Well Drilled For: Well Class: Type Equipment:
 Oil SWD Infield Mud Rotary
 Gas Inj Pool Ext. Air Rotary
 OWWO Expl Wildcat Cable

Ground surface elevation feet MSL

Domestic well within 330 feet: yes no

Municipal well within one mile: yes no

Surface pipe by Alternate: 1 2

Depth to bottom of fresh water. 258/150

Depth to bottom of usable water 200

Surface pipe planned to be set 250

Projected Total Depth 4200 feet

Formation Lansing

If OWWO: old well info as follows:

Operator

Well Name

Comp Date Old Total Depth

I certify that well will comply with K.S.A. 55-101, et seq., plus eventually plugging hole to KCC specifications.

 cementing will be done immediately upon setting production casing.

Date 11/4/86 Signature of Operator or Agent John S. Weir Title President

For KCC Use:

Conductor Pipe Required feet; Minimum Surface Pipe Required 250 feet per Alt. ① ② ③

This Authorization Expires 5-6-87 Approved By 11-6-86

Handwritten initials/signature


Handwritten initials/signature

Must be filed with the K.C.C. five (5) days prior to commencing well
This card void if drilling not started within six (6) months of date received by K.C.C.

Important procedures to follow:

1. Notify District office before setting surface casing.
2. Set surface casing by circulating cement to the top.
3. File completion forms ACO-1 with K.C.C. within 90 days of well completion, following instructions on ACO-1, side 1, and including copies of wireline logs.
4. Notify District office 48 hours prior to old well workover or re-entry.
5. Prior to filing Intent, prepare a proposed plugging plan in case well is D & A, then obtain approval of plan when calling district office prior to setting surface pipe.
6. Submit plugging report (CP-4) to K. C. C. after plugging is completed.
7. Obtain an approved injection docket number before disposing of salt water.
8. Notify K.C.C. within 10 days when injection commences or terminates.
9. If an alternate 2 completion, cement in the production pipe from below any usable water to surface within 120 days of spud date.

**A Regular Section of Land
1 Mile = 5,280 Ft.**

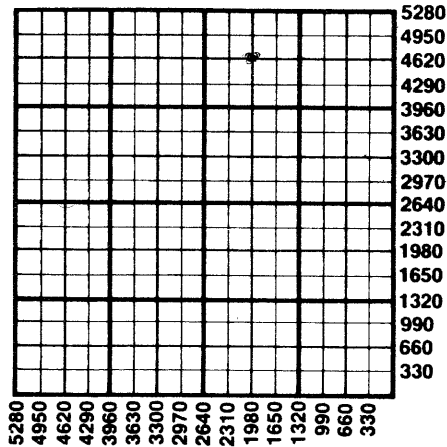

NOV 6 1980
11-6-80

State Corporation Commission of Kansas
Conservation Division
200 Colorado Derby Building
Wichita, Kansas 67202
(316) 263-3238