

CARD MUST BE TYPED

State of Kansas

CARD MUST BE SIGNED

NOTICE OF INTENTION TO DRILL

(see rules on reverse side)

P
Starting Date 7 13 87
month day year

API Number 15- 153-20,689-00-00

OPERATOR: License # 9325
Name Allied Oil Company Inc.
Address Rt #2 Box 45-A
City/State/Zip Taneyville, Mo. 65799
Contact Person Roy Grant
Phone 417-546-5885

C 1/2 SE SE Sec. 20 Twp. 1 S, Rg. 33 X East
330 West
660 Ft. from South Line of Section
Ft. from East Line of Section

(Note: Locate well on Section Plat on reverse side)

CONTRACTOR: License # 5671
Name Revlin Drlg., Inc.
City/State Box 293 Russell, Kansas 67665

Nearest lease or unit boundary line 330 feet
County Rawlins
Lease Name Vap Well # #2

Well Drilled For: Well Class: Type Equipment:
X Oil SWD X Infield X Mud Rotary
Gas Inj Pool Ext. Air Rotary
OWWO Expl Wildcat Cable

Ground surface elevation feet MSL
Domestic well within 330 feet: yes X no
Municipal well within one mile: yes X no

If OWWO: old well info as follows:
Operator
Well Name
Comp Date Old Total Depth

Depth to bottom of fresh water 175'
Depth to bottom of usable water 175'
Surface pipe by Alternate: 1 X 2
Surface pipe planned to be set 250'
Conductor pipe required n/a
Projected Total Depth 4150 feet
Formation Lansing

I certify that well will comply with K.S.A. 55-101, et seq., plus eventually plugging hole to KCC specifications.
Date 7-6-87 Signature of ~~Operator~~ Operator or Agent Laura J. Gibson Title Agent


For KCC Use:
Conductor Pipe Required feet; Minimum Surface Pipe Required 250 feet per Alt. 1 X
This Authorization Expires 1-7-88 Approved By RCH 7-7-87

Must be filed with the K.C.C. five (5) days prior to commencing well
 This card void if drilling not started within six (6) months of date received by K.C.C.

Important procedures to follow:

1. Notify District office before setting surface casing.
2. Set surface casing by circulating cement to the top.
3. File completion forms ACO-1 with K.C.C. within 90 days of well completion, following instructions on ACO-1, side 1, and including copies of wireline logs.
4. Notify District office 48 hours prior to old well workover or re-entry.
5. Prior to filing Intent, prepare a proposed plugging plan in case well is D & A, then obtain approval of plan when calling district office prior to setting surface pipe.
6. Submit plugging report (CP-4) to K. C. C. after plugging is completed.
7. Obtain an approved injection docket number before disposing of salt water.
8. Notify K.C.C. within 10 days when injection commences or terminates.
9. If an alternate 2 completion, cement in the production pipe from below any usable water to surface within 120 days of spud date.

A Regular Section of Land
1 Mile = 5,280 Ft.

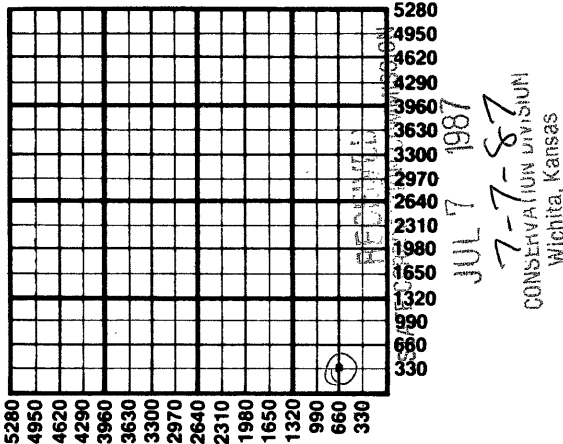

State Corporation Commission of Kansas
 Conservation Division
 200 Colorado Derby Building
 Wichita, Kansas 67202
 (316) 263-3238