

CARD MUST BE TYPED

State of Kansas

CARD MUST BE SIGNED

NOTICE OF INTENTION TO DRILL

(see rules on reverse side)

Expected Spud Date. June 18, 1988
month day year

API Number 15-153-20,718-00-00

OPERATOR: License # 9325
Name Allied Oil Company
Address Rt. #2, Box 45A
City/State/Zip Taneyville, Missouri 65759
Contact Person Roy A. Grant
Phone (417)-546-5885

SW SW NE Sec. 17 Twp. 1 S, Rg. 33
2970 Ft. from South Line of Section
2310 Ft. from East Line of Section

(Note: Locate well on Section Plat on reverse side)

CONTRACTOR: License # 8241
Name Emphasis Oil Operations
City/State Russell, KS 67665

Nearest lease or unit boundary line 330 feet
County Rawlins
Lease Name Kopriva 'B' Well # 1

Well Drilled For: Well Class: Type Equipment:
 Oil Storage Infield Mud Rotary
 Gas Inj Pool Ext. Air Rotary
 OWWO Expl Wildcat Cable

Ground surface elevation EST. 2950' feet MSL
Domestic well within 330 feet: yes no
Municipal well within one mile: yes no

If OWWO: old well info as follows:
Operator
Well Name
Comp Date Old Total Depth

Depth to bottom of fresh water. 80'
Depth to bottom of usable water 280' 200'
Surface pipe by Alternate: 1 2
Surface pipe planned to be set 320'
Conductor pipe required N/A
Projected Total Depth 4275' feet
Formation Lansing-Kansas City

I certify that well will comply with K.S.A. 55-101, et seq., plus eventually plugging hole to KCC specifications.
Date 6-13-88 Signature of Operator or Agent [Signature] Title Agent

For KCC Use:
Conductor Pipe Required _____ feet; Minimum Surface Pipe Required _____ feet per Alt. 1
This Authorization Expires 12-14-88 Approved By [Signature] 6-14-88


EFFECTIVE DATE: 12-19-88

Must be filed with the K.C.C. five (5) days prior to commencing well
 This card void if drilling not started within six (6) months of date received by K.C.C.

Important procedures to follow:

1. Notify District office before setting surface casing.
2. Set surface casing by circulating cement to the top.
3. File completion forms ACO-1 with K.C.C. within 120 days of well spud date, following instructions on ACO-1, side 1, and including copies of wireline logs.
4. Notify District office 48 hours prior to old well workover or re-entry.
5. Prior to filing Intent, prepare a proposed plugging plan in case well is D & A, then obtain approval of plan when calling district office prior to setting surface pipe.
6. Submit plugging report (CP-4) to K.C.C. after plugging is completed.
7. Obtain an approved injection docket number before disposing of salt water.
8. Notify K.C.C. within 10 days when injection commences or terminates.
9. If an alternate 2 completion, cement in the production pipe from below any usable water to surface within 120 days of spud date.

A Regular Section of Land
1 Mile = 5,280 Ft.

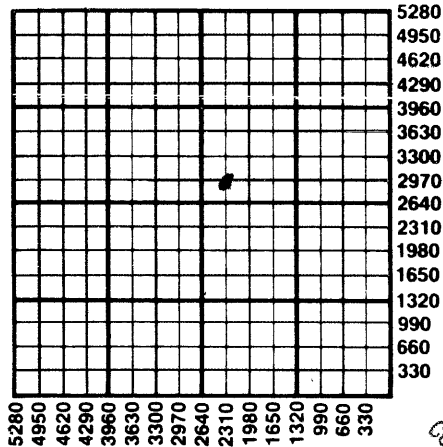

STATE CORPORATION COMMISSION
 RECEIVED
 JUN 14 1988
 6-14-88
 CONSERVATION DIVISION
 Wichita, Kansas

State Corporation Commission of Kansas
 Conservation Division
 200 Colorado Derby Building
 Wichita, Kansas 67202-1212
 (316) 263-3238