

CARD MUST BE TYPED

State of Kansas

CARD MUST BE SIGNED

NOTICE OF INTENTION TO DRILL

(see rules on reverse side)

Starting Date August 23, 1986
month day year 3 '86

API Number 15— 153-20,663-00-00
SE. NE. SE. Sec. 16 Twp. 1 S, Rg. 33 East
X West
1650 Ft. from South Line of Section 16
330 Ft. from East Line of Section 16

OPERATOR: License # 5267
Name K. & E. Petroleum, Inc.
Address 100 S. Main, Ste. 300
City/State/Zip Wichita, KS 67202
Contact Person Wayne L. Brinegar
Phone 316-264-4301

(Note: Locate well on Section Plat on reverse side)
Nearest lease or unit boundary line 330 feet
County Rawlins
Lease Name Vap Well # 6

CONTRACTOR: License # 5422
Name Abercrombie Drilling, Inc.
City/State Wichita, Kansas 67202

Ground surface elevation 2896 feet MSL
Domestic well within 330 feet: —yes X no
Municipal well within one mile: —yes X no

Well Drilled For: Well Class: Type Equipment:
X Oil — SWD — Infield X Mud Rotary
— Gas — Inj — X Pool Ext. — Air Rotary
— OWWO — Expl — Wildcat — Cable

Depth to bottom of fresh water 130
Depth to bottom of usable water 220
Surface pipe by Alternate: 1 X 2
Surface pipe planned to be set 250'
Conductor pipe required None
Projected Total Depth 4150' feet
Formation Marmaton

If OWWO: old well info as follows:
Operator N/A
Well Name
Comp Date Old Total Depth

I certify that well will comply with K.S.A. 55-101, et seq., plus eventually plugging hole to KCC specifications.
Date 8/20/86 Signature of Operator or Agent Wayne L. Brinegar Title Vice President


For KCC Use:
Conductor Pipe Required _____ feet; Minimum Surface Pipe Required 200 feet per Alt.
This Authorization Expires 2-20-87 Approved By 8-20-86

Must be filed with the K.C.C. five (5) days prior to commencing well
 This card void if drilling not started within six (6) months of date received by K.C.C.

Important procedures to follow:

1. Notify District office before setting surface casing.
2. Set surface casing by circulating cement to the top.
3. File completion forms ACO-1 with K.C.C. within 90 days of well completion, following instructions on ACO-1, side 1, and including copies of wireline logs.
4. Notify District office 48 hours prior to old well workover or re-entry.
5. Prior to filing Intent, prepare a proposed plugging plan in case well is D & A, then obtain approval of plan when calling district office prior to setting surface pipe.
6. Submit plugging report (CP-4) to K. C. C. after plugging is completed.
7. Obtain an approved injection docket number before disposing of salt water.
8. Notify K.C.C. within 10 days when injection commences or terminates.
9. If an alternate 2 completion, cement in the production pipe from any usable water to surface within 120 days of spud date.

A Regular Section of Land
1 Mile = 5,280 Ft.

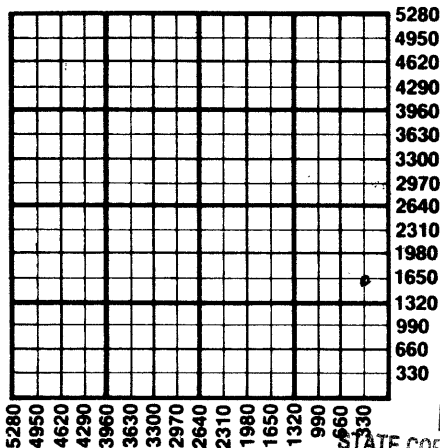

RECEIVED
 STATE CORPORATION COMMISSION

11/20/1986
 8-20-86
 CONSERVATION DIVISION
 Wichita, Kansas

State Corporation Commission of Kansas
 Conservation Division
 200 Colorado Derby Building
 Wichita, Kansas 67202
 (316) 263-3238