

CARD MUST BE TYPED



State of Kansas

CARD MUST BE SIGNED

NOTICE OF INTENTION TO DRILL

(see rules on reverse side)

15-153-20631-06-01

Starting Date 12 month 12 day 86 year

API Number 15-153-20631-A

OPERATOR: License # 9682
Name Golden Eagle Drilling, Inc.
Address P.O. Box 983
City/State/Zip McCook, Nebraska 69001
Contact Person Darwin Pierson
Phone 309-345-3839

SE SE SE Sec 9 Twp 1 S, Rg 33 West
330 Ft. from South Line of Section
330 Ft. from East Line of Section

(Note: Locate well on Section Plat on reverse side)

CONTRACTOR: License # 8682
Name Golden Eagle Drilling, Inc.
City/State P.O. Box 983 McCook, Ne. 69001

Nearest lease or unit boundary line 330 feet
County Rawlins
Lease Name Sramek Well # 9-64

Well Drilled For: Well Class: Type Equipment:
X Oil SWD Infield X Mud Rotary
Gas Inj X Pool Ext Air Rotary
X OWWO Expl Wildcat Cable

Ground surface elevation feet MSL
Domestic well within 330 feet yes X no
Municipal well within one mile yes X no
Surface pipe by Alternate: 1 X 2

If OWWO: old well info as follows:
Operator Raco Oil
Well Name Sramek #1
Comp Date 9-29-85 Old Total Depth 4195

Depth to bottom of fresh water 200
Depth to bottom of usable water 225
Surface pipe planned to be set 3.19
Projected Total Depth 4100 feet
Formation L.K.C.

I certify that well will comply with K.S.A. 55-101, et seq., plus eventually plugging hole to KCC specifications.

Date 12-9-86 Signature of Operator or Agent [Signature] Title President


For KCC Use:
Conductor Pipe Required feet; Minimum Surface Pipe Required 319 feet per Alt.
This Authorization Expires 6-1-87 Approved By [Signature] 12-11-86

Must be filed with the K.C.C. five (5) days prior to commencing well
 This card void if drilling not started within six (6) months of date received by K.C.C.

Important procedures to follow:

1. Notify District office before setting surface casing.
2. Set surface casing by circulating cement to the top.
3. File completion forms ACO-1 with K.C.C. within 90 days of well completion, following instructions on ACO-1, side 1, and including copies of wireline logs.
4. Notify District office 48 hours prior to old well workover or re-entry.
5. Prior to filing Intent, prepare a proposed plugging plan in case well is D & A, then obtain approval of plan when calling district office prior to setting surface pipe.
6. Submit plugging report (CP-4) to K.C.C. after plugging is completed.
7. Obtain an approved injection docket number before disposing of salt water.
8. Notify K.C.C. within 10 days when injection commences or terminates.

A Regular Section of Land
1 Mile = 5,280 Ft.

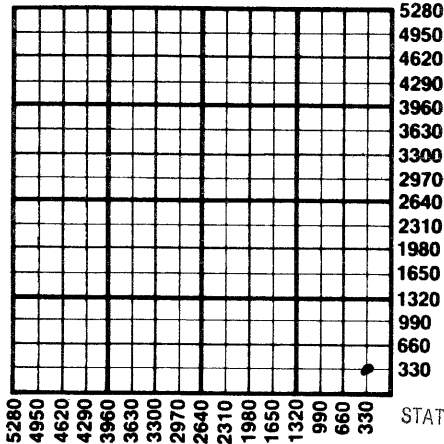

RECEIVED
 STATE CORPORATION COMMISSION
 If an alternate 2 completion, cement in the production pipe from below any usable water to surface within 120 days of spud date.

DEC 11 1960

CONSERVATION DIVISION
 Wichita, Kansas

12-11-86

State Corporation Commission of Kansas
 Conservation Division
 200 Colorado Derby Building
 Wichita, Kansas 67202
 (316) 263-3238