

CARD MUST BE TYPED

State of Kansas

CARD MUST BE SIGNED

NOTICE OF INTENTION TO DRILL

(see rules on reverse side)

Starting Date August 22, 1986 month day year

API Number 15-153-20,662-00-00

OPERATOR: License # 5783

SE NW SW Sec. 15 Twp. 1 S, Rg. 33 East West

Name Galloway Drilling Co., Inc.

Address 340 Broadway Plaza Bldg., 105 S. Broadway

City/State/Zip Wichita, KS 67202

Contact Person Susan Kendall

Phone (316) 263-1793

CONTRACTOR: License # 6033

Name Murfin Drilling Company

City/State/Zip Wichita, KS 67202

Well Drilled For: Well Class: Type Equipment:

X Oil SWD Infield X Mud Rotary
Gas Inj Pool Ext Air Rotary
OWWO Expl Wildcat Cable

If OWWO: old well info as follows:

Operator

Well Name

Comp Date Old Total Depth

I certify that well will comply with K.S.A. 55-101, et seq., plus eventually plugging hole to KCC specifications.

Date 8/13/86 Signature of Operator or Agent

1650 Ft. from South Line of Section

4290 Ft. from East Line of Section

(Note: Locate well on Section Plat on reverse side)

Nearest lease or unit boundary line 330 feet

County Rawlins

Lease Name Vap Well # "A" #1

Ground surface elevation 2920 feet MSL

Domestic well within 330 feet: yes X no

Municipal well within one mile: yes X no

Depth to bottom of fresh water 100

Depth to bottom of usable water 150

Surface pipe by Alternate: 1 X 2

Surface pipe planned to be set 200

Conductor pipe required -0-

Projected Total Depth 4150 feet

Formation Base Kansas City

Title President Jay H. Galloway

For KCC Use:

Conductor Pipe Required feet; Minimum Surface Pipe Required 200 feet per Alt. 1


This Authorization Expires 2-14-87 Approved By KCH 8-14-86

Must be filed with the K.C.C. five (5) days prior to commencing well
This card void if drilling not started within six (6) months of date received by K.C.C.

Important procedures to follow:

1. Notify District office before setting surface casing.
2. Set surface casing by circulating cement to the top.
3. File completion forms ACO-1 with K.C.C. within 90 days of well completion, following instructions on ACO-1, side 1, and including copies of wireline logs.
4. Notify District office 48 hours prior to old well workover or re-entry.
5. Prior to filing Intent, prepare a proposed plugging plan in case well is D & A, then obtain approval of plan when calling district office prior to setting surface pipe.
6. Submit plugging report (CP-4) to K.C.C. after plugging is completed.
7. Obtain an approved injection docket number before disposing of salt water.
8. Notify K.C.C. within 10 days when injection commences or terminates.
9. If an alternate 2 completion, cement in the production pipe from below any usable water to surface within 120 days of spud date.

A Regular Section of Land
1 Mile = 5,280 Ft.

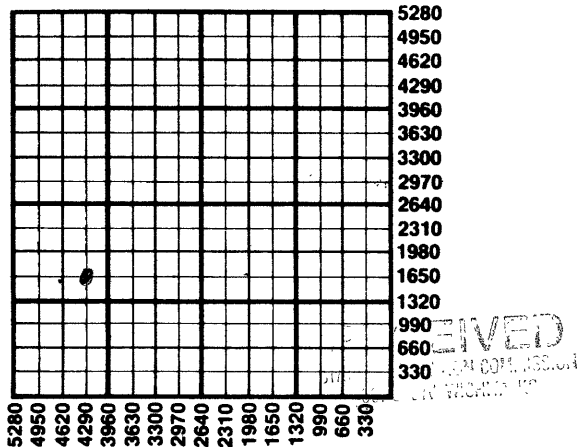

8-14-86
AUG 14 1986

State Corporation Commission of Kansas
Conservation Division
200 Colorado Derby Building
Wichita, Kansas 67202
(316) 263-3238