

CARD MUST BE TYPED

State of Kansas

CARD MUST BE SIGNED

# NOTICE OF INTENTION TO DRILL

(see rules on reverse side)

Starting Date ... November 3, 1986  
month day year

API Number 15- 153-20,672-00-00

OPERATOR: License # 5783  
Name Galloway Drilling Co., Inc.  
Address 340 Broadway Plaza Bldg. 105 S. Broadway  
City/State/Zip Wichita, KS 67202  
Contact Person Susan Kendall  
Phone (316) 263-1793

\_\_\_\_\_ East  
NW NW SW Sec. 15. Twp. 1. S, Rg. 33.  West  
2310  
4950  
Ft. from South Line of Section  
Ft. from East Line of Section

(Note: Locate well on Section Plat on reverse side)

CONTRACTOR: License # 5783  
Name Galloway Drilling Co., Inc.  
City/State Wichita, KS 67202

Nearest lease or unit boundary line 330 feet  
County Rawlins

Lease Name Vap Well # A-3  
Ground surface elevation 2895' feet MSL

Well Drilled For: Well Class: Type Equipment:  
 Oil \_\_\_\_\_ SWD \_\_\_\_\_ Infield  Mud Rotary  
\_\_\_\_\_ Gas \_\_\_\_\_ Inj  Pool Ext. \_\_\_\_\_ Air Rotary  
\_\_\_\_\_ OWWO \_\_\_\_\_ Expl \_\_\_\_\_ Wildcat \_\_\_\_\_ Cable

Domestic well within 330 feet: \_\_\_\_\_ yes  no  
Municipal well within one mile: \_\_\_\_\_ yes  no

Depth to bottom of fresh water 100  
Depth to bottom of usable water 150

Surface pipe by Alternate: 1  2 \_\_\_\_\_  
Surface pipe planned to be set 200

Conductor pipe required -0-  
Projected Total Depth 4150 feet

Formation Base Kansas City

If OWWO: old well info as follows:

Operator \_\_\_\_\_  
Well Name \_\_\_\_\_  
Comp Date \_\_\_\_\_ Old Total Depth \_\_\_\_\_

I certify that well will comply with K.S.A. 55-101, et seq., plus eventually plugging hole to KCC specifications.

Date 10/15/86 Signature of Operator or Agent Jay H. Galloway Title President

For KCC Use:

Conductor Pipe Required \_\_\_\_\_ feet; Minimum Surface Pipe Required 200 feet per Alt. 1

This Authorization Expires 4-20-87 Approved By 10-20-86

*[Handwritten signature]*


Must be filed with the K.C.C. five (5) days prior to commencing well  
This card void if drilling not started within six (6) months of date received by K.C.C.

RECEIVED  
STATE CORPORATION COMMISSION  
CONS. DIV. WICHITA, KS

10-20-86

A Regular Section of Land  
1 Mile = 5,280 Ft.

OCT 20 1986

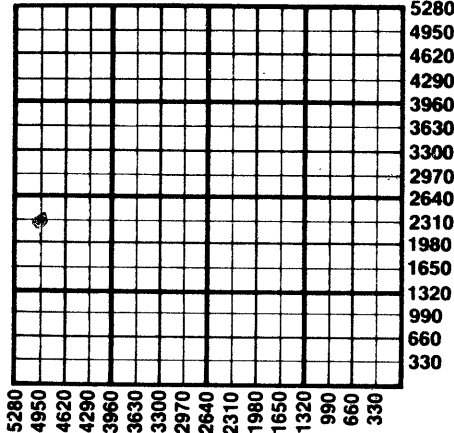

Important procedures to follow:

1. Notify District office before setting surface casing.
2. Set surface casing by circulating cement to the top.
3. File completion forms ACO-1 with K.C.C. within 90 days of well completion, following instructions on ACO-1, side 1, and including copies of wireline logs.
4. Notify District office 48 hours prior to old well workover or re-entry.
5. Prior to filing Intent, prepare a proposed plugging plan in case well is D & A, then obtain approval of plan when calling district office prior to setting surface pipe.
6. Submit plugging report (CP-4) to K.C.C. after plugging is completed.
7. Obtain an approved injection docket number before disposing of salt water.
8. Notify K.C.C. within 10 days when injection commences or terminates.
9. If an alternate 2 completion, cement in the production pipe from below any usable water to surface within 120 days of spud date.

State Corporation Commission of Kansas  
Conservation Division  
200 Colorado Derby Building  
Wichita, Kansas 67202  
(316) 263-3238

CARD MUST BE TYPED

State of Kansas

CARD MUST BE SIGNED

NOTICE OF INTENTION TO DRILL

(see rules on reverse side)

130 days

Starting Date November 3, 1986 month day year

API Number 15-153-20,672-00-00

OPERATOR: License # 5783

NW NW SW Sec. 15 Twp. 1 S, Rg. 33 East

Name Galloway Drilling Co., Inc.

2310 Ft. from South Line of Section

Address 340 Broadway Plaza Bldg. 105 S. Broadway

4950 Ft. from East Line of Section

City/State/Zip Wichita, KS 67202

(Note: Locate well on Section Plat on reverse side)

Contact Person Susan Kendall

Nearest lease or unit boundary line 330 feet

Phone (316) 263-1793

County Rawlins

CONTRACTOR: License # 5783

Lease Name Vap Well # A-3

Name Galloway Drilling Co., Inc.

Ground surface elevation 2895' feet MSL

City/State Wichita, KS 67202

Well Drilled For: Well Class: Type Equipment:

Domestic well within 330 feet: yes no

X Oil SWD Infield X Mud Rotary

Municipal well within one mile: yes no

Gas Inj X Pool Ext Air Rotary

Depth to bottom of fresh water 100

OWWO Expl Wildcat Cable

Depth to bottom of usable water 150

If OWWO: old well info as follows:

Surface pipe by Alternate: 1 X 2

Operator

Surface pipe planned to be set 200 210

Well Name

Conductor pipe required -0-

Comp Date Old Total Depth

Projected Total Depth 4150 feet

I certify that well will comply with K.S.A. 55-101, et seq., plus eventually plugging hole to KCC specifications.

Date 10/15/86 Signature of Operator or Agent Jay H. Galloway Title President

For KCC Use:

Conductor Pipe Required feet; Minimum Surface Pipe Required 200 feet per Alt.

This Authorization Expires 4-20-87 Approved By 10-20-86

Carl McQuire pond DonD

10/31/86 PM

Signature

NW NW SW Sec. 15 Twp. 1 S, Rg. 33 East

PLUGGING PROPOSAL IF ABOVE IS D & A

This plugging proposal will be reviewed and approved or revised at the time the district office is called prior to setting surface casing (call 7 a.m. to 5 p.m. workdays).

Table with 4 columns: Plug number, Depth (feet), Plug length (feet), and Cement quantity (sxs).

NOTE: Agreement between operator and district office on plug placement and the amount of cement to be used is necessary prior to plugging. In Addition: Call district office after well is either plugged or production casing is cemented in.

(Call 7 a.m. to 5 p.m. workdays)

District office use only:

API #15-153-20,672 Surface casing of feet set with sxs at hours, 19 Alternate 1 or 2 surface pipe was used. Alternate 2 cementing was completed @ ft. depth with sxs on 19 Hole plugged 19, agent

10/27/86