

CARD MUST BE TYPED

State of Kansas

CARD MUST BE SIGNED

NOTICE OF INTENTION TO DRILL

(see rules on reverse side)

Starting Date 12 5 86
month day year

OPERATOR: License # 9800

Name Double R Oil Co., Inc.

Address Box 506

City/State/Zip McCook, NE 69001

Contact Person Roger W. Philpot

Phone 913-626-3104

CONTRACTOR: License # 6033

Name Murfin Drilling Company

City/State Wichita, KS 67202

Well Drilled For:	Well Class:	Type Equipment:
<input checked="" type="checkbox"/> Oil	<input type="checkbox"/> SWD	<input type="checkbox"/> Infield
<input type="checkbox"/> Gas	<input type="checkbox"/> Inj	<input checked="" type="checkbox"/> Mud Rotary
<input type="checkbox"/> OWWO	<input type="checkbox"/> Expl	<input type="checkbox"/> Air Rotary
	<input type="checkbox"/> Wildcat	<input type="checkbox"/> Cable

If OWWO: old well info as follows:

Operator

Well Name

Comp Date Old Total Depth

I certify that well will comply with K.S.A. 55-101, et seq., plus eventually plugging hole to KCC specifications.

Date 11-26-86. Signature of Operator or Agent

Rob Ramseyer, Agent for Operator

API Number 15- 153-20,679-00-00
 150' W C
 NW NE NW Sec. 22 Twp. 1 S, Rg. 33 West
 4950 Ft. from South Line of Section
 3780 Ft. from East Line of Section

(Note: Locate well on Section Plat on reverse side)

Nearest lease or unit boundary line .330 feet

County Rawlins

Lease Name Baumfalk Well # 3-622

Ground surface elevation 2903 feet MSL

Domestic well within 330 feet: yes no

Municipal well within one mile: yes no

Depth to bottom of fresh water 150

Depth to bottom of usable water 200

Surface pipe by Alternate: 1 2

Surface pipe planned to be set 200

Conductor pipe required N/A

Projected Total Depth 4150 feet

Formation LKC

I certify that well will comply with K.S.A. 55-101, et seq., plus eventually plugging hole to KCC specifications.

Date 11-26-86. Signature of Operator or Agent Rob Ramseyer, Agent for Operator Title Ass't. Drlg. Mgr.

For KCC Use:

Conductor Pipe Required feet; Minimum Surface Pipe Required 200 feet per Alt. ①

This Authorization Expires 5-26-87 Approved By 11-26-86


[Handwritten signatures and initials]

Must be filed with the K.C.C. five (5) days prior to commencing well
 This card void if drilling not started within six (6) months of date received by K.C.C.

Important procedures to follow:

1. Notify District office before setting surface casing.
2. Set surface casing by circulating cement to the top.
3. File completion forms ACO-1 with K.C.C. within 90 days of well completion, following instructions on ACO-1, side 1, and including copies of wireline logs.
4. Notify District office 48 hours prior to old well workover or re-entry.
5. Prior to filing Intent, prepare a proposed plugging plan in case well is D & A, then obtain approval of plan when calling district office prior to setting surface pipe.
6. Submit plugging report (CP-4) to K. C. C. after plugging is completed.
7. Obtain an approved injection docket number before disposing of salt water.
8. Notify K.C.C. within 10 days when injection commences or terminates.

A Regular Section of Land
1 Mile = 5,280 Ft.

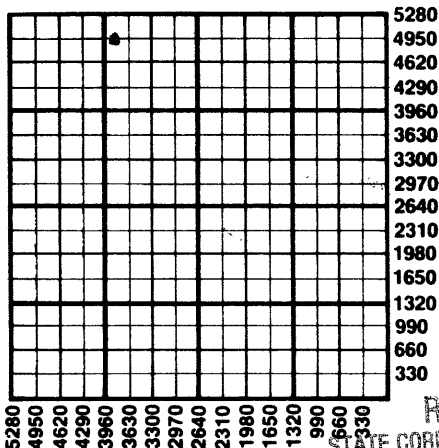

RECEIVED
 STATE CORPORATION COMMISSION

NOV 26 1986
 11-26-86
 CONSERVATION DIVISION
 Wichita, Kansas

in alternate 2 completion, cement in the production pipe from below any usable water to surface within 120 days of spud date.

State Corporation Commission of Kansas
 Conservation Division
 200 Colorado Derby Building
 Wichita, Kansas 67202
 (316) 263-3238