

CARD MUST BE TYPED

State of Kansas

CARD MUST BE SIGNED

NOTICE OF INTENTION TO DRILL

(see rules on reverse side)

Starting Date 09 08 86
 month day year 1:22

OPERATOR: License # 9800
Name Double R Oil Co., Inc.
Address Box 506
City/State/Zip McCook, NE 69001
Contact Person Roger W. Philpott
Phone 913-626-3104

CONTRACTOR: License # 6033
Name Murfin Drilling Company
City/State Wichita, KS

Well Drilled For:	Well Class:	Type Equipment:
<input checked="" type="checkbox"/> Oil <input type="checkbox"/> SWD <input type="checkbox"/> Infield <input checked="" type="checkbox"/> Mud Rotary		
<input type="checkbox"/> Gas <input type="checkbox"/> Inj <input checked="" type="checkbox"/> Pool Ext. <input type="checkbox"/> Air Rotary		
<input type="checkbox"/> OWWO <input type="checkbox"/> Expl <input type="checkbox"/> Wildcat <input type="checkbox"/> Cable		

If OWWO: old well info as follows:
Operator
Well Name
Comp Date Old Total Depth

I certify that well will comply with K.S.A. 55-101, et seq., plus eventually plugging hole to KCC specifications.

~~Operator's name~~

Date 9-5-86 Signature of Operator or Agent Rob Ramseyer, Agent for Operator Title Ass't. Drilling Manager

For KCC Use:
Conductor Pipe Required feet; Minimum Surface Pipe Required feet per Alt. 200
This Authorization Expires 3-5-87 Approved By 9-5-86

API Number 15- 153-20,666-00-00
120' E C
NW SW NW Sec. 22 Twp. 1 S, Rg. 33 West
3630
4830
Ft. from South Line of Section
Ft. from East Line of Section

(Note: Locate well on Section Plat on reverse side)

Nearest lease or unit boundary line 450 feet
County Rawlins
Lease Name Baumfalk Well # 2-4022
Ground surface elevation 2976 feet MSL
Domestic well within 330 feet: yes no
Municipal well within one mile: yes no
Surface pipe by Alternate: 1 X 2
Depth to bottom of fresh water 150
Depth to bottom of usable water 200
Surface pipe planned to be set 200
Projected Total Depth 4150 feet
Formation LKC


RCA/KCC

Must be filed with the K.C.C. five (5) days prior to commencing well
 This card void if drilling not started within six (6) months of date received by K.C.C.

Important procedures to follow:

1. Notify District office before setting surface casing.
2. Set surface casing by circulating cement to the top.
3. File completion forms ACO-1 with K.C.C. within 90 days of well completion, following instructions on ACO-1, side 1, and including copies of wireline logs.
4. Notify District office 48 hours prior to old well workover or re-entry.
5. Prior to filing Intent, prepare a proposed plugging plan in case well is D & A, then obtain approval of plan when calling district office prior to setting surface pipe.
6. Submit plugging report (CP-4) to K.C.C. after plugging is completed.
7. Obtain an approved injection docket number before disposing of salt water.
8. Notify K.C.C. within 10 days when injection commences or terminates.

A Regular Section of Land
1 Mile = 5,280 Ft.

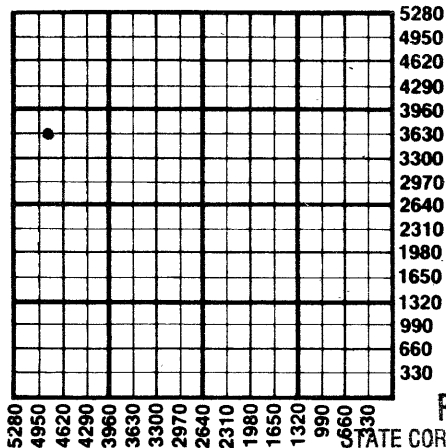

RECEIVED

STATE CORPORATION COMMISSION

SEP 5 - 1986

9-5-86

CONSERVATION DIVISION
 Wichita, Kansas

If on alternate 2 completion, cement in the production pipe from below any usable water to surface within 120 days of spud date.

State Corporation Commission of Kansas
 Conservation Division
 200 Colorado Derby Building
 Wichita, Kansas 67202
 (316) 263-3238