

CARD MUST BE TYPED

State of Kansas

CARD MUST BE SIGNED

NOTICE OF INTENTION TO DRILL

(see rules on reverse side)

Starting Date August 10, 1986
month day year

API Number 15- 153-20, 660-0000
East

OPERATOR: License # 8682
Name Golden Eagle Drilling
Address P.O. Box 983
City/State/Zip McCook, NE 69001
Contact Person Darwin Pierson
Phone (308) 345-3839

SE NE NE Sec. 21 Twp. 1 S, Rg. 33 XX West
4240
330
Ft. from South Line of Section
Ft. from East Line of Section

(Note: Locate well on Section Plat on reverse side)

CONTRACTOR: License # 8682
Name Golden Eagle Drilling
City/State McCook, NE 69001

Nearest lease or unit boundary line 330 feet
County Rawlins
Lease Name Reunitz Well # 21-1A

Well Drilled For: Well Class: Type Equipment:
X Oil — SWD — Infield XX Mud Rotary
— Gas — Inj XX Pool Ext. — Air Rotary
— OWWO — Expl — Wildcat — Cable

Ground surface elevation 2984 feet MSL
Domestic well within 330 feet: — yes XXno
Municipal well within one mile: — yes XXno
Surface pipe by Alternate: 1 X 2

If OWWO: old well info as follows:
Operator
Well Name
Comp Date Old Total Depth

Depth to bottom of fresh water 200'
Depth to bottom of usable water 225'
Surface pipe planned to be set 300'
Projected Total Depth 4200 feet
Formation Lansing-Kansas City

I certify that well will comply with K.S.A. 55-101, et seq., plus eventually plugging hole to KCC specifications.

Date 8-8-87 Signature of Operator or Agent Rebecca K. Crawford Title Agent

For KCC Use:
Conductor Pipe Required feet; Minimum Surface Pipe Required 245 feet per Alt. 1
This Authorization Expires 2-8-87 Approved By B. Storg

Must be filed with the K.C.C. five (5) days prior to commencing well
 This card void if drilling not started within six (6) months of date received by K.C.C.

Important procedures to follow:

RECEIVED
STATE CORPORATION COMMISSION

1. Notify District office before setting surface casing.

A Regular Section of Land
1 Mile = 5,280 Ft.

AUG 8 1986
SS-86
CONSERVATION DIVISION
 5280
 Wichita, Kansas

2. Set surface casing by circulating cement to the top.

3. File completion forms ACO-1 with K.C.C. within 90 days of well completion, following instructions on ACO-1, side 1, and including copies of wireline logs.

4. Notify District office 48 hours prior to old well workover or re-entry.


5. Prior to filing Intent, prepare a proposed plugging plan in case well is D & A, then obtain approval of plan when calling district office prior to setting surface pipe.

6. Submit plugging report (CP-4) to K.C.C. after plugging is completed.

7. Obtain an approved injection docket number before disposing of salt water.

8. Notify K.C.C. within 10 days when injection commences or terminates.

9. If an alternate 2 completion, cement in the production pipe from below any usable water to surface within 120 days of spud date.

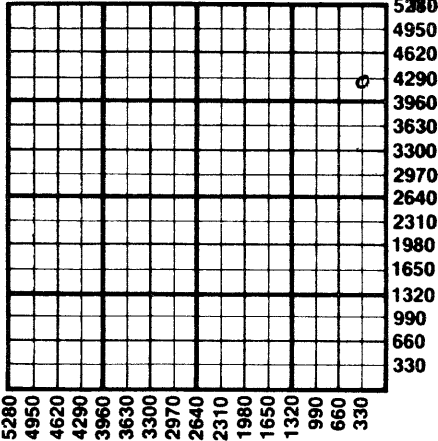

State Corporation Commission of Kansas
 Conservation Division
 200 Colorado Derby Building
 Wichita, Kansas 67202
 (316) 263-3238