

CARD MUST BE TYPED

State of Kansas

CORRECTED

CARD MUST BE SIGNED

NOTICE OF INTENTION TO DRILL *8-5-86*

Starting Date ..... 08 08 86 (see rules on reverse side)  
month day year

API Number 15- 153-20,657-00-00

OPERATOR: License # 9800  
Name Double R Oil Co., Inc.  
Address 506 P. O. Box 506  
City/State/Zip McCook, NE 69001  
Contact Person Roger W. Philpott  
Phone 913-626-3104

*k 90'* E C N/2 NW NE 21 Sec. 21 Twp. 1 S, Rg. 33 East  
\_\_\_\_\_ West  
4950 Ft. from South Line of Section  
\* 1890 Ft. from East Line of Section

(Note: Locate well on Section Plat on reverse side)

CONTRACTOR: License # 6033  
Name Murfin Drilling Company  
City/State Wichita, KS

Nearest lease or unit boundary line 330 feet  
County Rawlins  
Lease Name Vap. "B" Well # 1-321

Well Drilled For: Well Class: Type Equipment:  
 Oil \_\_\_\_\_ SWD \_\_\_\_\_ Infield  Mud Rotary  
\_\_\_\_\_ Gas \_\_\_\_\_ Inj  Pool Ext. \_\_\_\_\_ Air Rotary  
\_\_\_\_\_ OWWO \_\_\_\_\_ Expl \_\_\_\_\_ Wildcat \_\_\_\_\_ Cable

Ground surface elevation 2897 feet MSL  
Domestic well within 330 feet: \_\_\_\_\_yes no  
Municipal well within one mile: \_\_\_\_\_yes no

If OWWO: old well info as follows:

Operator .....  
Well Name .....  
Comp Date ..... Old Total Depth.....

Depth to bottom of fresh water 150  
Depth to bottom of usable water 200  
Surface pipe by Alternate: 1  2 \_\_\_\_\_  
Surface pipe planned to be set 200' 8-5/8"  
Conductor pipe required .....  
Projected Total Depth 4150 feet  
Formation Lansing-Kansas City

I certify that well will comply with K.S.A. 55-101, et seq., plus eventually plugging hole to KCC specifications.

Date 8-5-86 Signature of Operator or Agent

*Rob Ramseyer*  
Rob Ramseyer, Agent for Operator Title Ass't. Drilling Manager

For KCC Use:

Conductor Pipe Required ..... feet Minimum Surface Pipe Required ..... feet per Alt.  4  
This Authorization Expires *1-15-87* Approved By *7-15-86*


*Kwas: CNE NW NE  
1650PEL*

Must be filed with the K.C.C. five (5) days prior to commencing well  
 This card void if drilling not started within six (6) months of date received by K.C.C.

**Important procedures to follow:**

1. Notify District office before setting surface casing.
2. Set surface casing by circulating cement to the top.
3. File completion forms ACO-1 with K.C.C. within 90 days of well completion, following instructions on ACO-1, side 1, and including copies of wireline logs.
4. Notify District office 48 hours prior to old well workover or re-entry.
5. Prior to filing Intent, prepare a proposed plugging plan in case well is D & A, then obtain approval of plan when calling district office prior to setting surface pipe.
6. Submit plugging report (CP-4) to K.C.C. after plugging is completed.
7. Obtain an approved injection docket number before disposing of salt water.
8. Notify K.C.C. within 10 days when injection commences or terminates.
9. If an alternate 2 completion, cement in the production pipe from below any usable water to surface within 120 days of spud date.

**A Regular Section of Land**  
**1 Mile = 5,280 Ft.**

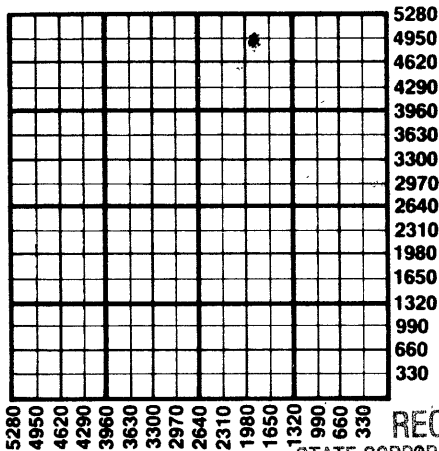

**RECEIVED**  
 STATE CORPORATION COMMISSION

**AUG 5 1986**  
*8-5-86*  
 CONSERVATION DIVISION  
 Wichita, Kansas

State Corporation Commission of Kansas  
 Conservation Division  
 200 Colorado Derby Building  
 Wichita, Kansas 67202  
 (316) 263-3238