

STATE CORPORATION COMMISSION OF KANSAS
OIL & GAS CONSERVATION DIVISION
RECOMPLETION FORM
ACO-2 AMENDMENT TO WELL HISTORY

Operator: License # 3667
Name Source Petroleum
Address 200 W. Douglas, Suite 820
City/State/Zip Wichita, KS 67202

Purchaser Koch Oil Company

Operator Contact Person Charles Schmidt
Phone 316 262-7397

Designate Type of Original Completion
 New Well Re-Entry Workover
 Oil SWD Temp Abd
 Gas Inj Delayed Comp.
 Dry Other (Core, Water Supply etc.)

Date of Original Completion: 5/28/88

DATE OF RECOMPLETION:
5/23/89 5/26/89
Commenced Completed

Designate Type of Recompletion/Workover:
 Deepening Delayed Completion
 Plug Back Re-perforation
 Conversion to Injection/Disposal

Is recompleted production:
N/A Commingled; Docket No. _____
N/A Dual Completion; Docket No. _____
 Other (Disposal or Injection)?

API NO. 15- 153-20-712-00-01
County Rawlins
SE NE NW Sec 24 Twp 1S Rge 33 East West


4290 Ft North from Southeast Corner of Section
2970 Ft West from Southeast Corner of Section
(Note: Locate well in section plat below)

Lease Name Timm "A" Well # 4

Field Name Wilhelm *Wilhelm*

Name of New Formation Lansing-Kansas City

Elevation: Ground 2975' KB 2980'
Section Plat

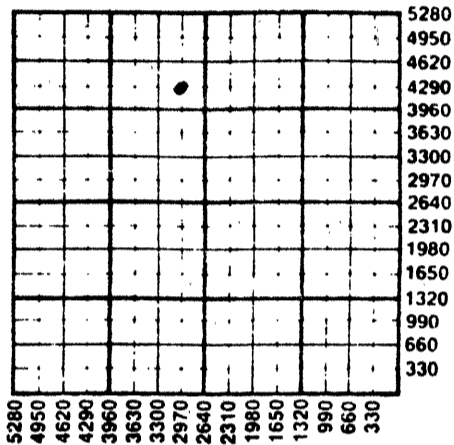


K. C. C. OFFICE USE ONLY
 Letter of Confidentiality Attached
 Wireline Log Received
 Drillers' Timelog Received
Distribution
 KCC SWD/Rep NGPA
 KGS Plug Other
(Specify)
.....
.....
6-9-89 4

INSTRUCTIONS: This form shall be completed in triplicate and filed with the Kansas Corporation Commission, 200 Colorado Derby Building, Wichita, Kansas 67202, within 120 days of the recompletion of any well. Rules 82-3-107 and 82-3-141 apply. Information on side two of this form will be held confidential for a period of 12 months if requested in writing and submitted with the form. See rule 82-3-107 for confidentiality in excess of 12 months. One copy of any additional wireline logs and driller's time logs (not previously submitted) shall be attached with this form. Submit ACO-4 prior to or with this form for approval of commingling or dual completions. Submit CP-4 with all plugged wells. Submit CP-111 with all temporarily abandoned wells. NOTE: Conversion of wells to either disposal or injection must receive approval before use; submit form U-1.

All requirements of the statutes, rules and regulations promulgated to regulate the oil and gas industry have been fully complied with and the statements herein are complete and correct to the best of my knowledge.

Signature John D. Howard, Jr. Title General Manager Date 6/5/89
Subscribed and sworn to before me this 6th day of June 19 89

Notary Public Virginia S. Fabian Date Commission Expires August 5, 1991
Virginia S. Fabian

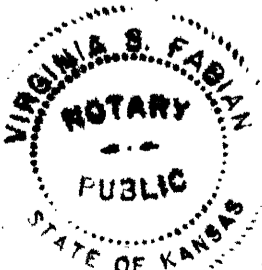

RECEIVED FORM ACO-2
STATE CORPORATION COMMISSION
JUN 9 1989
CONSERVATION DIVISION
Wichita, Kansas