


Give All Information Completely  
Make Required Affidavit  
Mail or Deliver Report to:  
Conservation Division  
State Corporation Commission  
211 No. Broadway  
Wichita, Kansas

WELL PLUGGING RECORD

NORTH

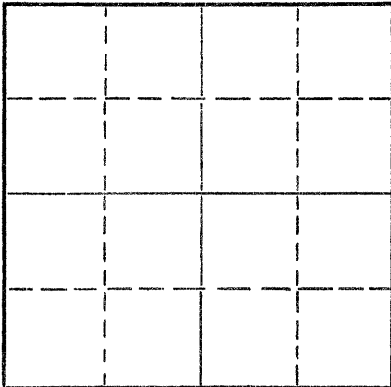

Locate well correctly on above  
Section Plat

Rawlins County, Sec. 28 Twp. 1S Rge. (E) 32 (W)  
Location as "NE/CNW%SW%" or footage from lines C SE SW  
Lease Owner Burch Exploration, Ltd.  
Lease Name RUEBER Well No. 1  
Office Address 1011 Union Center, Wichita, Kansas  
Character of Well (completed as Oil, Gas or Dry Hole) Dry Hole  
Date well completed November 3, 19 63  
Application for plugging filed verbally - November 2, 19 63  
Application for plugging approved verbally - November 2, 19 63  
Plugging commenced November 3, 19 63  
Plugging completed November 3, 19 63  
Reason for abandonment of well or producing formation Dry

If a producing well is abandoned, date of last production 19  
Was permission obtained from the Conservation Division or its agents before plugging was commenced? verbally

Name of Conservation Agent who supervised plugging of this well  
Producing formation Depth to top Bottom Total Depth of Well 4180 Feet  
Show depth and thickness of all water, oil and gas formations.

OIL, GAS OR WATER RECORDS

CASING RECORD

FORMATION	CONTENT	FROM	TO	SIZE	PUT IN	PULLED OUT
				8-5 / 8"	256'	None

Describe in detail the manner in which the well was plugged, indicating where the mud fluid was placed and the method or methods used in introducing it into the hole. If cement or other plugs were used, state the character of same and depth placed, from feet to feet for each plug set.

Filled hole with heavy mud to 600'  
Set 1st plug at 600' w/20 sx cement through drill pipe  
Set 2nd plug at 250' with 1/4 sx hulls, 20 sx cement  
Set Top plug at 40' w/ plug & 8 sx cement.  
Rat Hole 25 sx.

RECEIVED  
STATE CORPORATION COMMISSION  
11-12-1963  
NOV 12 1963

CONSERVATION DIVISION  
Wichita, Kansas

(If additional description is necessary, use BACK of this sheet)  
Name of Plugging Contractor Abercrombie Drilling, Inc.  
Address 801 Union Center, Wichita, Kansas

STATE OF Kansas COUNTY OF Sedgwick  
I, B. Lynn Herrington (employee of contractor or (owner or operator) of the above-described well, being first duly sworn on oath, says: That I have knowledge of the facts, statements, and matters herein contained and the log of the above-described well as filed and that the same are true and correct. So help me God

(Signature) B. Lynn Herrington  
801 Union Center, Wichita, Kansas  
(Address)

SUBSCRIBED AND SWORN to before me this 8th day of November, 19 63

My commission expires June 16, 1967 Notary Public.

CONTRACTOR'S WELL LOG

15-153-30031-00-00

COMPANY: Burch Exploration, Ltd.  
 CONTRACTOR: Abercrombie Drilling, Inc.  
 FARM: RUEBER #1  
 LOCATION: C SE SW Section 28-1S-32W  
 Rawlins County, Kansas  
 COMMENCED: October 23, 1963  
 COMPLETED: November 3, 1963

0	50	Sand
50	265	Shale
265	470	Shale & Shells
470	1280	Shale
1280	2100	Shale
2100	2340	Shale & Lime
2340	2370	Shale
2370	2416	Blaine Anhydrite
2416	2697	Shale
2697	2698	Shale & Lime
2698	2738	Cimarron Anhydrite
2738	3630	Shale & Lime
3630	3808	Lime
3808	3925	Shale & Lime
3925	3935	Lime
3935	4185	Lime & Shale
4135	4180	Lime
	4180	Rotary Total Depth

RECEIVED  
 STATE CORPORATION COMMISSION  
 11-12-1963  
 NOV 12 1963  
 CONSERVATION DIVISION  
 Wichita, Kansas

ELECTRIC LOG TOPS:

ELEVATION: 2933' K. B.

Severy	3688'	(- 755)
Topeka	3713'	(- 780)
Deer Creek	3760'	(- 827)
Oread	3808'	(- 875)
Douglas Sand	3834'	(- 901)
Lansing	3855'	(- 922)
Base Kansas City	4106'	(-1173)

Set 8-5/8" surface at 256' w/125 sx cement

DRY & ABANDONED

STATE OF KANSAS )  
 ) SS  
 COUNTY OF SEDGWICK )

I, B. Lynn Herrington, do hereby certify that the above and foregoing is a true and correct copy of the log of the RUEBER #1, C SE SW, Section 28-1S-32W, Rawlins County, Kansas, as reflected by the files of Abercrombie Drilling, Inc.

B. Lynn Herrington  
 B. Lynn Herrington

Subscribed and sworn to before me, a Notary Public, in and for Sedgwick County, Kansas, this 8th day of November, 1963.

Leah Faye Hefke  
 Leah Faye Hefke, Notary Public

My commission expires June 16, 1967.