

Give All Information Completely
Make Required Affidavit
Mail or Deliver Report to:
Conservation Division
State Corporation Commission
211 No. Broadway
Wichita, Kansas


WELL PLUGGING RECORD

15-153-30028-00-00

Rawlins County, Sec. 30 Twp. 1S Rge. 32W (E) (W)

Location as "NE/CNW%SW%" or footage from lines 600' FNL & 600' FWL NE/4
Lease Owner Sam G. Harrison
Lease Name F. D. Simminger Well No. 1
Office Address 2400 Bank of the Southwest Bldg., Houston 2, Texas
Character of Well (completed as Oil, Gas or Dry Hole) Dry Hole
Date well completed February 12 19 64
Application for plugging filed February 12 19 64
Application for plugging approved February 12 19 64
Plugging commenced February 12 19 64
Plugging completed February 12 19 64
Reason for abandonment of well or producing formation Dry Hole

NORTH

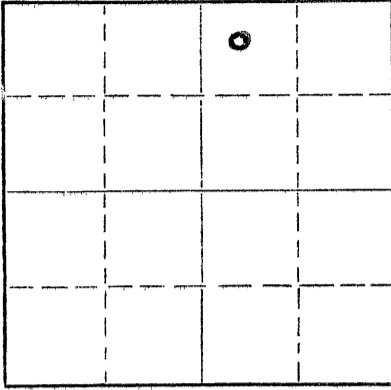

Locate well correctly on above
Section Plat

If a producing well is abandoned, date of last production _____ 19____
Was permission obtained from the Conservation Division or its agents before plugging was commenced? Yes

Name of Conservation Agent who supervised plugging of this well W. L. Nichols
Producing formation None Depth to top _____ Bottom _____ Total Depth of Well 4250 Feet
Show depth and thickness of all water, oil and gas formations.

OIL, GAS OR WATER RECORDS

CASING RECORD

FORMATION	CONTENT	FROM	TO	SIZE	PUT IN	PULLED OUT
Sand	Water	250	265	8-5/8"OD	281'	None

Describe in detail the manner in which the well was plugged, indicating where the mud fluid was placed and the method or methods used in introducing it into the hole. If cement or other plugs were used, state the character of same and depth placed, from _____ feet to _____ feet for each plug set.

Mud, 9.8#, 67 Viscosity, From 4250' to 600' w/Pump

Cement, Regular Neat, 25 Sacks displaced through drill pipe @ 600'

Mud

Cement, Regular Neat, 15 Sacks displaced through drill pipe @ 290'

Mud

Cement, Regular Neat, 10 sacks displaced through drill pipe @ 40'

RECEIVED
STATE CORPORATION COMMISSION
03-02-1964
MAR 2 1964

CONSERVATION DIVISION
Wichita, Kansas

(If additional description is necessary, use BACK of this sheet)

Name of Plugging Contractor Halliburton Oil Well Cementing Company
Address McCook, Nebraska

STATE OF TEXAS, COUNTY OF HARRIS, ss.
WM. S. SHROPSHIRE (employee of owner) or (owner or operator) of the above-described

well, being first duly sworn on oath, says: That I have knowledge of the facts, statements and matters herein contained and the log of the above-described well as filed and that the same are true and correct. So help me God.

(Signature) Wm S Shropshire

2400 Bank of the Southwest Bldg., Houston, 2, Texas
(Address)

SUBSCRIBED AND SWORN TO before me this 28th day of February, 19 64

My commission expires 6-1-65

Berta L. Rubright
BERTA L. RUBRIGHT Notary Public.

15-153-30028-00-00

COMPANY: Sam G. Harrison, 2400 Bank of the Southwest Bldg., Houston 2, Texas
 CONTRACTOR: Stoeppelwerth Drilling Company, P. O. Drawer 193, Russell, Kansas
 FARM: F. D. Simminger #1
 LOCATION: 600' East and 600' South of NW Corner of NW¼ of NE¼, Section 30, T1S, R32W, Rawlins County, Kansas
 COMMENCED: February 1, 1964 ELEVATION: 3018 KB
 COMPLETED: February 12, 1964 POTENTIAL: Dry Hole

* * * * *

0	to	281	Shale
281	to	1530	Shale
1530	to	2360	Sand - Shale - Pyrite Streaks
2360	to	2610	Shale - Lime
2610	to	2625	Blain
2625	to	2835	Shale
2835	to	2876	Anhydrite
2876	to	3040	Shale - Lime
3040	to	3425	Lime - Shale
3425	to	3520	Shale - Lime
3520	to	3745	Lime - Shale
3745	to	4045	Lime
4045	to	4085	Lime
4085	to	4250	Lime
4250	to	TD	

RECEIVED
STATE CORPORATION COMMISSION

SET: 281' 8 5/8" with 175 sacks cement.

MAR 2 1964

ELECTRIC LOG TOPS:


Topeka	3825	- 807
Oread	3934	- 916
Douglas Sand	3960	- 942
Lansing - Kansas City	3980	- 962
Base - Kansas City	4242	-1224
Schlumberger Total		
Depth	4250	

CONSERVATION DIVISION
Wichita, Kansas

* * * * *

C E R T I F I C A T I O N

I, William S. Shropshire, do hereby certify that the above and foregoing is a true and correct copy of the log on the F. D. Simminger #1, 600' East and 600' South of NW Corner of NW¼ of NE¼, Section 30, T1S, R32W, Rawlins County, Kansas, as reflected by the files of Sam G. Harrison, Oil.



 WM. S. SHROPSHIRE,
 ENGINEER

Subscribed and sworn to before me, a Notary Public, within and for Harris County, Texas, this 28th day of February, 1964.



 BERTA L. RUBRIGHT, NOTARY PUBLIC

MY COMMISSION EXPIRES: 6-1-65