

CARD MUST BE TYPED

State of Kansas

CARD MUST BE SIGNED

NOTICE OF INTENTION TO DRILL

(see rules on reverse side)

Starting Date 08 29 86 month day year 3:48

OPERATOR: License # 9800
Name Double R Oil Co.
Address Box 506
City/State/Zip McCook, NE 69001
Contact Person Roger Philpott
Phone 913-626-3104

CONTRACTOR: License # 6033
Name Murfin Drilling Company
City/State Wichita, KS

Well Drilled For: Well Class: Type Equipment:
[X] Oil [ ] SWD [ ] Infield [X] Mud Rotary
[ ] Gas [ ] Inj [ ] Pool Ext. [ ] Air Rotary
[ ] OWWO [ ] Expl [X] Wildcat [ ] Cable

If OWWO: old well info as follows:

Operator
Well Name
Comp Date Old Total Depth

I certify that well will comply with K.S.A. 55-101, et seq., plus eventually plugging hole to KCC specifications.

Date 8-28-86 Signature of Operator or Agent Robert A. Ramseyer Title Ass't. Drilling Manager
Robert A. Ramseyer, Agent for Operator

For KCC Use:

Conductor Pipe Required 250 feet; Minimum Surface Pipe Required 250 feet per Alt.
This Authorization Expires 2-28-87 Approved By 8-28-86

API Number 15-153-20.66400-00
100' SE C
NW NW NE 27 1 33 East
4880 Sec Twp S, Rg X West
2240 Ft. from South Line of Section
Ft. from East Line of Section

(Note: Locate well on Section Plat on reverse side)


Nearest lease or unit boundary line 400 feet
County Rawlins
Lease Name Huss "A" Well # 1-427
Ground surface elevation 3001 feet MSL
Domestic well within 330 feet: yes X no
Municipal well within one mile: yes X no
Surface pipe by Alternate: 1 2
Depth to bottom of fresh water 150 200
Depth to bottom of usable water 250
Surface pipe planned to be set 200 250
Projected Total Depth 4150 feet
Formation LKC

Must be filed with the K.C.C. five (5) days prior to commencing well  
 This card void if drilling not started within six (6) months of date received by K.C.C.

**Important procedures to follow:**

1. Notify District office before setting surface casing.
2. Set surface casing by circulating cement to the top.
3. File completion forms ACO-1 with K.C.C. within 90 days of well completion, following instructions on ACO-1, side 1, and including copies of wireline logs.
4. Notify District office 48 hours prior to old well workover or re-entry.
5. Prior to filing Intent, prepare a proposed plugging plan in case well is D & A, then obtain approval of plan when calling district office prior to setting surface pipe.
6. Submit plugging report (CP-4) to K. C. C. after plugging is completed.
7. Obtain an approved injection docket number before disposing of salt water.
8. Notify K.C.C. within 10 days when injection commences or terminates.

**A Regular Section of Land**  
**1 Mile = 5,280 Ft.**

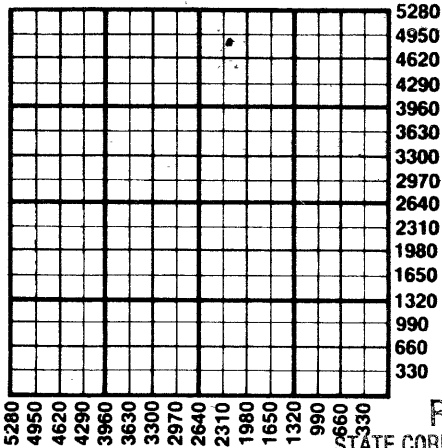

RECEIVED

STATE CORPORATION COMMISSION

AUG 28 1986

8-28-86  
 CONSERVATION DIVISION  
 Wichita, Kansas

If an alternate 2 completion, cement in the production pipe from below any usable water to surface within 120 days of spud date.

State Corporation Commission of Kansas  
 Conservation Division  
 200 Colorado Derby Building  
 Wichita, Kansas 67202  
 (316) 263-3238