

FORM MUST BE TYPED
FORM C-1 12/88

State of Kansas
NOTICE OF INTENTION TO DRILL

FORM MUST BE SIGNED
ALL BLANKS MUST BE FILLED

Must be approved by the K.C.C. five (5) days prior to commencing well

Expected Spud Date .. JUNE .. 10th .. 1989 ..
month day year

NW .. NE .. SW .. Sec 32 .. Twp 1 .. S, Rg 32 .. X East
West

2310 .. feet from South line of Section
3630 .. feet from East line of Section

OPERATOR: License # .. 5046 ..
Name: .. Raymond Oil Company, Inc. & Bruce Anderson ..
Address: .. P. O. Box 48788 ..
City/State/Zip: .. Wichita, KS 67201 ..
Contact Person: .. Pat Raymond, Vice President ..
Phone: .. 316/267-4214 ..

(Note: Locate well on Section Plat Below)

County: .. Rawlins ..

Lease Name: .. Kastens .. Well #: 1 ..

Field Name: .. wildcat ..

Is this a Prorated Field? .. yes X .. no

Target Formation(s): .. Lansing-Kansas City ..

Nearest lease or unit boundary: .. 990' ..

Ground Surface Elevation: .. 2986 .. feet MSL

Domestic well within 330 feet: .. yes X .. no

Municipal well within one mile: .. yes X .. no

Depth to bottom of fresh water: .. 220' ..

Depth to bottom of usable water: .. 2100' ..

Surface Pipe by Alternate: .. X 1 .. 2

Length of Surface Pipe Planned to be set: .. 300'+ ..

Length of Conductor pipe required: .. NONE ..

Projected Total Depth: .. 4200' ..

Formation at Total Depth: .. Lansing-Kansas City ..

Water Source for Drilling Operations:

.. well X farm pond .. other

DWR Permit #: ..

Will Cores Be Taken?: .. yes X .. no

If yes, proposed zone: ..

Well Drilled For: Well Class: Type Equipment:

X Oil .. Inj .. Infield X Mud Rotary
.. Gas .. Storage .. Pool Ext. .. Air Rotary
.. OAWO .. Disposal X Wildcat .. Cable
.. Seismic; .. # of Holes

If OAWO: old well information as follows:

Operator: ..
Well Name: ..
Comp. Date: .. Old Total Depth ..

Directional, Deviated or Horizontal wellbore? .. yes X .. no

If yes, total depth location: ..

WAS: Raymond Oil Co, Inc.
NE-NW-SW
4290' FEL
GL Elev 2986

AFFIDAVIT

MAILED
JUN 5 1989
CONSERVATION DIVISION
Wichita, Kansas


The undersigned hereby affirms that the drilling, completion and eventual plugging of this well will comply with K.S.A. 55-101, et. seq.

It is agreed that the following minimum requirements will be met:

1. The appropriate district office shall be notified before setting surface pipe;
2. The minimum amount of surface pipe as specified above shall be set by circulating cement to the top; in all cases surface pipe shall be set through all unconsolidated materials plus a minimum of 20 feet into the underlying formation;
3. If the well is dry, a plugging proposal shall be submitted to the district office. An agreement between the operator and the district office on plug length and placement is necessary prior to plugging;
4. The appropriate district office will be notified before well is either plugged or production casing is cemented in;
5. If an Alternate II completion, production pipe shall be cemented from below any usable water to surface within 120 days of spud date. In all cases, notify district office prior to any cementing.

I hereby certify that the statements made herein are true and to the best of my knowledge and belief.

Date: .. 5-31-89 .. Signature of Operator or Agent: Pat Raymond .. Title: Vice President ..

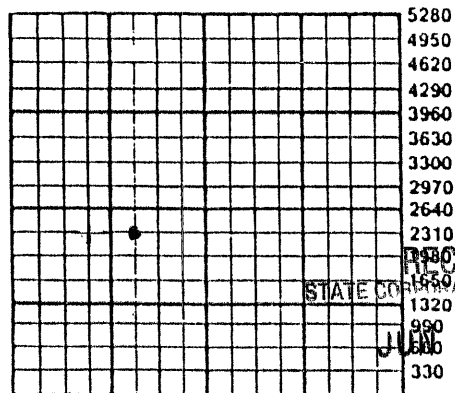

RECEIVED
STATE CORPORATION COMM. DIVISION
06-02-1989
JUN - 2 1989

RECEIVED
CONSERVATION DIVISION
Wichita, Kansas

JUN 7 1989

FOR KCC-USE:
API # 15- 153-20,736-00-00 DA
Conductor pipe required NONE feet
Minimum surface pipe required 300' feet per Alt. (1) X
Approved by: DPW 6-02-89/DPW 6-12-89
EFFECTIVE DATE: 6-07-89
This authorization expires: 12-02-89
(This authorization void if drilling not started within 6 months of effective date.)
Spud date: _____ Agent: _____

REMEMBER TO:

- File Drill Pit Application (form CDP-1) with Intent to Drill;
- File Completion Form ACO-1 within 120 days of spud date;
- File acreage attribution plat according to field proration orders;
- Notify appropriate district office 48 hours prior to workover or re-entry;
- Submit plugging report (CP-4) after plugging is completed;
- Obtain written approval before disposing or injecting salt water.

32
15
32w