


15-153-05194-00-00

Give All Information Completely
Make Required Affidavit
Mail or Deliver Report to:
Conservation Division
State Corporation Commission
212 North Market, Insurance Bldg.
Wichita, Kansas

WELL PLUGGING RECORD

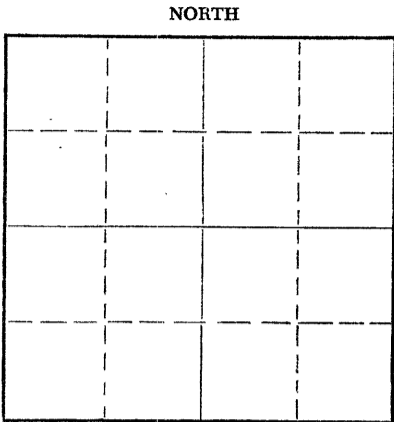

Locate well correctly on above
Section Plat

Rawlins County. Sec. 14 Twp. 1S Rge. 34W (E) (W)
Location as "NE/CNW/SW" or footage from lines SE NW NW
Lease Owner Imperial Oil of Kansas, Inc.
Lease Name Fikan Well No. 1
Office Address 780 Fourth National Bldg., Wichita 2, Kansas
Character of Well (completed as Oil, Gas or Dry Hole) Dry Hole
Date well completed July 30, 19 59
Application for plugging filed July 30, 19 59
Application for plugging approved July 30, 19 59
Plugging commenced July 30, 19 59
Plugging completed July 30, 19 59
Reason for abandonment of well or producing formation No commercial quantities of oil found.

If a producing well is abandoned, date of last production 19
Was permission obtained from the Conservation Division or its agents before plugging was commenced? Yes

Name of Conservation Agent who supervised plugging of this well Mr. A. D. Fabricius
Producing formation _____ Depth to top _____ Bottom _____ Total Depth of Well 4758 Feet
Show depth and thickness of all water, oil and gas formations.

OIL, GAS OR WATER RECORDS

CASING RECORD

FORMATION	CONTENT	FROM	TO	SIZE	PUT IN	PULLED OUT
				8-5/8"	450'	450'

Describe in detail the manner in which the well was plugged, indicating where the mud fluid was placed and the method or methods used in introducing it into the hole. If cement or other plugs were used, state the character of same and depth placed, from _____ feet to _____ feet for each plug set.

First Plug set at 600' with 20
sacks cement; No. 2 Plug at
400' with 20 sacks cement;
No. 3 Plug at 40' with 10 sacks
cement.

RECEIVED
STATE CORPORATION COMMISSION
OCT 21 1959
CONSERVATION DIVISION
Wichita, Kansas

(If additional description is necessary, use BACK of this sheet)
Name of Plugging Contractor Imperial Oil of Kansas, Inc. 10-21-59
Address 780 Fourth National Bldg., Wichita 2, Kansas

STATE OF KANSAS, COUNTY OF SEDGWICK, ss.
Raymond L. Bacon (employee of ~~owner~~ or former proprietor) of the above-described well, being first duly sworn on oath, says: That I have knowledge of the facts, statements, and matters herein contained and the log of the above-described well as filed and that the same are true and correct. So help me God. IMPERIAL OIL OF KANSAS, INC.
(Signature) By: Raymond L. Bacon V-P
780 Fourth National Bldg., Wichita 2, Kansas
(Address)

SUBSCRIBED AND SWORN TO before me this 23rd day of September, 19 59
Mona L. Latier
Mona L. Latier Notary Public.
My commission expires July 7, 1962



DRILLER'S LOG

Imperial Oil of Kansas, Inc.
780 Fourth National Building
Wichita 2, Kansas

15-153-05194-00-00

Fikan No. 1
SE NW NW Sec. 14-1S-34W
Rawlins County, Kansas

Total Depth: 4758'

Elevation: 3144' R.B.
Production: D & A

Commenced: 7-14-59 Completed: 7-30-59

Contractor: Imperial Oil of Kansas, Inc.
Wichita 2, Kansas

Casing Record: Set 8-5/8" Surface Pipe at 450' with 325 sacks cement.

Figures indicate bottom of formations:

		<u>TOPS</u>	
Shale	450'		
Shells & Shale	1800'	Anhydrite	2989' (/ 155)
Shale & Sand	2097'	Heebner	3996' (- 852)
Shells & Shale	2215'	Toronto	4013' (- 869)
Shale & Streaks of Iron	2400'	Lansing	4051' (- 907)
Hard Sand & Shale	2473'	Base Kansas City	4320' (-1176)
Sand	2505'	Cherokee	4488' (-1344)
Sand, Shale & Shells	2620'	Mississippi	4665' (-1521)
Shale & Iron	2675'	Quartzite	4756' (-1612)
Shale & Sand	2688'	Rotary Total Depth	4758' (-1614)
Anhydrite	2750'		
Red Bed & Shale	2791'		
Anhydrite	2804'		
Shale	2991'		
Anhydrite	3027'		
Shale & Lime	3070'		
Shale & Red Bed	3220'		
Shale	3370'		
Shale & Lime	4080'		
Lime	4560'		
Lime & Sand	4638'		
Lime & Chert	4740'		
Sand & Granite	4758'		
Total Depth	4758'		

We hereby certify this to be a correct and accurate log of the above described well, as shown on the daily drilling reports.

IMPERIAL OIL OF KANSAS, INC.

By: *V. Bacon*
Vice-President

Subscribed and sworn to before me this 22nd day of September, 1959.

My Commission Expires:

July 7, 1962

RECEIVED
STATE CORPORATION COMMISSION

OCT 21 1959

CONSERVATION DIVISION
Wichita, Kansas

Mona L. Latier
Mona L. Latier - Notary Public