


15-153-20044-00-00

STATE OF KANSAS
STATE CORPORATION COMMISSION

WELL PLUGGING RECORD

Give All Information Completely
Make Required Affidavit
Mail or Deliver Report to:
Conservation Division
State Corporation Commission
200 Colorado
Derby Bldg.
Wichita, Kansas
67202 NORTH

Rawlins County, Sec. 15 Twp. 1S Rge. (E) 34 (W)
Location as "NE/CNW/SW" or footage from lines C SE SW
Lease Owner Halliburton Oil Producing Company
Lease Name Thieler Well No. 2
Office Address 2915 Classen Blvd., Okla. City, Okla. 73106
Character of Well (completed as Oil, Gas or Dry Hole) Oil
Date well completed July 30, 19 81
Application for plugging filed August 25, 19 81
Application for plugging approved August 31, 19 81
Plugging commenced August 31, 19 81
Plugging completed August 31, 19 81
Reason for abandonment of well or producing formation Noncommercial
Was water injection well.

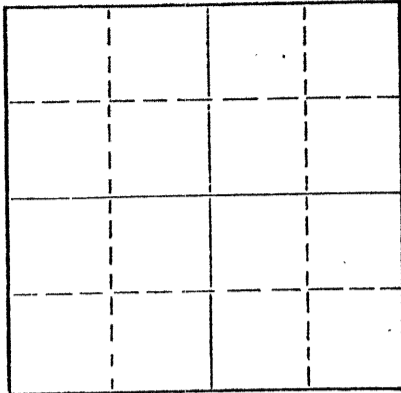

Locate well correctly on above Section Plat

If a producing well is abandoned, date of last production 19
Was permission obtained from the Conservation Division or its agents before plugging was commenced? Yes

Name of Conservation Agent who supervised plugging of this well Gilbert Balthazor
Producing formation K. C. Lansing Depth to top 4156' Bottom 4296' Total Depth of Well 4337 Feet
Show depth and thickness of all water, oil and gas formations.

OIL, GAS OR WATER RECORDS

CASING RECORD

FORMATION	CONTENT	FROM	TO	SIZE	PUT IN	PULLED OUT
K. C. Lansing	Oil	4156'	4296'	8-5/8"	310'	None
				4-1/2"	4335'	None

Describe in detail the manner in which the well was plugged, indicating where the mud fluid was placed and the method or methods used in introducing it into the hole. If cement or other plugs were used, state the character of same and depth placed, from feet to feet for each plug set.

4-1/2" casing not pulled. Plugged w/40 sacks cement, 20 sacks of gel, and 3 sacks of cotton seed hulls.

RECEIVED
STATE CORPORATION COMMISSION
SEP 21 1981

(If additional description is necessary, use BACK of this sheet)
Name of Plugging Contractor Halliburton Oil Producing Company
Address 300 Cameron Bldg., 2915 Classen Blvd., Oklahoma City, Okla. 73106

CONSERVATION DIVISION
Wichita, Kansas

STATE OF OKLAHOMA, COUNTY OF OKLAHOMA, ss.
M. E. Shaw (employee of owner) or (owner/producer) of the above-described

well, being first duly sworn on oath, says: That I have knowledge of the facts, statements, and matters herein contained and the log of the above-described well as filed and that the same are true and correct. So help me God.

(Signature) M. E. Shaw
2915 Classen Blvd., Okla. City, Okla.
(Address)

SUBSCRIBED AND SWORN TO before me this 18th day of September, 19 81

My commission expires April 24, 1985
Notary Public.