

STATE OF KANSAS  
STATE CORPORATION COMMISSION


15-193-05229-00-00

WELL PLUGGING RECORD

Give All Information Completely  
Make Required Affidavit  
Mail or Deliver Report to:  
Conservation Division  
State Corporation Commission  
800 Bitting Building  
Wichita, Kansas

Rawlins County, Sec. 12 Twp. 15 Rge. 34 (E) (W)

Location as "NE/CNW/SW" or footage from lines C NE SE  
Lease Owner The British-American Oil Producing Company  
Lease Name Horinek Well No. 1  
Office Address 502 Oil & Gas Building, Oklahoma City 2, Oklahoma  
Character of Well (completed as Oil, Gas or Dry Hole) Dry  
Date well completed March 15 19 60  
Application for plugging filed March 16 19 60  
Application for plugging approved March 17 19 60  
Plugging commenced March 16 19 60  
Plugging completed March 17 19 60  
Reason for abandonment of well or producing formation Dry

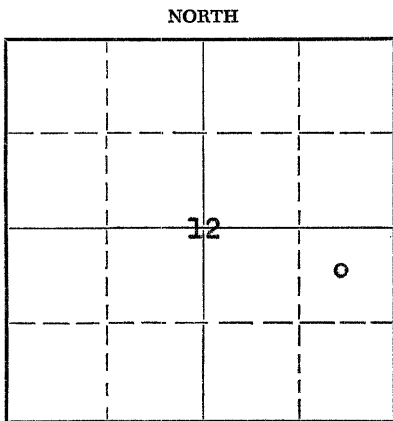

Locate well correctly on above  
Section Plat

If a producing well is abandoned, date of last production - 19 -

Was permission obtained from the Conservation Division or its agents before plugging was commenced? Yes

Name of Conservation Agent who supervised plugging of this well A. D. Fabricius

Producing formation - Depth to top - Bottom - Total Depth of Well - Feet

Show depth and thickness of all water, oil and gas formations.


OIL, GAS OR WATER RECORDS

CASING RECORD

FORMATION	CONTENT	FROM	TO	SIZE	PUT IN	PULLED OUT
None				8-5/8"	248'	None

Describe in detail the manner in which the well was plugged, indicating where the mud fluid was placed and the method or methods used in introducing it into the hole. If cement or other plugs were used, state the character of same and depth placed, from \_\_\_\_\_ feet to \_\_\_\_\_ feet for each plug set.

Loaded hole with heavy mud, spotted 20 sax cement at 400', 20 sax cement at 240', and 10 sax cement from 40' to surface.

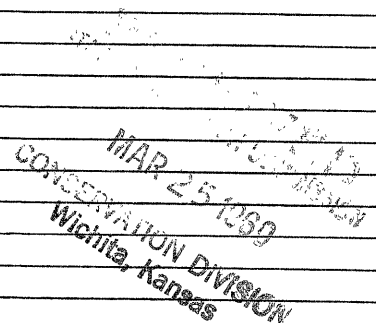

(If additional description is necessary, use BACK of this sheet)

Name of Plugging Contractor K & E Drilling Company 3-25-60  
Address 719 Union Center Bldg., Wichita, Kansas

STATE OF Oklahoma, COUNTY OF Oklahoma, ss.  
George W. Murphy (employee of owner) or (~~owner~~) of the above-described well, being first duly sworn on oath, says: That I have knowledge of the facts, statements, and matters herein contained and the log of the above-described well as filed and that the same are true and correct. So help me God.

(Signature) George W. Murphy  
502 Oil & Gas Building, Okla. City 2, Okla.  
(Address)

SUBSCRIBED AND SWORN TO before me this 23rd day of March 19 60

My commission expires 10-10-60 O O Floyd Notary Public.

15-193-05229-00-00

# DRILLER'S WELL LOG

OPERATOR: BRITISH-AMERICAN OIL PRODUCING COMPANY  
501 Oil & Gas Building  
Oklahoma City 2, Oklahoma

WELL NAME: #1 HORINEK  
LOCATION: NE SE  
Sec. 12-15-34W  
RAWLINS COUNTY, KANSAS

CONTRACTOR: K & E DRILLING, INC.  
719 UNION CENTER BLDG.  
WICHITA, KANSAS

COMMENCED: 3-5-60

CASING RECORD: 8-5/8" @ 248' (165 sx cmt)

COMPLETED: 3-16-60

ROTARY TOTAL DEPTH: 4640' KB

ELEVATION: UNKNOWN

PRODUCTION: D & A

## FORMATION RECORD

Depths shown indicate bottom of formations encountered.

Clay	70
Sandy Lime	90
Shale	1985
Shale & Sand	2350
Shale & Lime	2595
Shale	2620
Anhydrite	2670
Shale	2710
Red Bed	2922
Lime	2957
Shale & Shells	3135
Lime	3403
Lime & Shale	3755
Lime	4270
Cong. Shale	4380
Lime	4450
Lime & Shale	4585
Sand & Lime	4632
Granite	4640
R.T.D.	4640'

RECEIVED  
STATE CORPORATION COMMISSION  
MAR 23 1960  
3-23-60  
CONSERVATION DIVISION  
Wichita, Kansas

## CERTIFICATION

State of KANSAS }  
County of SEDGWICK } ss:

I, Dale Silcott, of K&E DRILLING, INC., upon oath state that the above and foregoing is a true and correct copy of the Driller's Log of the above named well.

Subscribed and sworn to before me this 21st day of March 1960

My Commission expires August 5, 1963 James L. Downing Notary Public.

