

CORRECTED

Correction as to location

For KCC Use: 6.21.04
Effective Date: _____
District # 1
SGA? Yes No

KANSAS CORPORATION COMMISSION
OIL & GAS CONSERVATION DIVISION

Form C-1
December 2002

Form must be Typed
Form must be Signed
All blanks must be Filled

NOTICE OF INTENT TO DRILL

Must be approved by KCC five (5) days prior to commencing well

Expected Spud Date 07/05/2004
month day year

Spot approx 110' west of
E/2 SE SE Sec. 30 Twp. 30 S. R. 18 East West
660 feet from N / S Line of Section
440 feet from E / W Line of Section
Is SECTION Regular Irregular?

OPERATOR: License# 8061
Name: Oil Producers, Inc. of Kansas **RECEIVED**
Address: P.O. Box 8647
City/State/Zip: Wichita, Ks. 67208 **JUN 24 2004**
Contact Person: Diana Richecky
Phone: 316-681-0231 **KCC WICHITA**

CONTRACTOR: License# 5123
Name: Pickrell Drilling Co., Inc.

(Note: Locate well on the Section Plat on reverse side)

County: KIOWA
Lease Name: EMERSON Well #: 1-30
Field Name: ALFORD

Is this a Prorated / Spaced Field? Yes No

Target Formation(s): MISSISSIPPI & STOTLER

Nearest Lease or unit boundary: 440

Ground Surface Elevation: EST 2207 feet MSL

Water well within one-quarter mile: Yes No

Public water supply well within one mile: Yes No

Depth to bottom of fresh water: 180

Depth to bottom of usable water: 240

Surface Pipe by Alternate: 1 2

Length of Surface Pipe Planned to be set: 650

Length of Conductor Pipe required: NONE

Projected Total Depth: 5150

Formation at Total Depth: STOTLER

Water Source for Drilling Operations:
 Well Farm Pond Other HAUL

DWR Permit #: _____

(Note: Apply for Permit with DWR)

Will Cores be taken? Yes No

If Yes, proposed zone: _____

Well Drilled For: Well Class: Type Equipment:

- | | | | |
|----------------------------------------------------|--------------------------------------|---------------------------------------------|------------------------------------------------|
| <input checked="" type="checkbox"/> Oil | <input type="checkbox"/> Enh Rec | <input checked="" type="checkbox"/> Infield | <input checked="" type="checkbox"/> Mud Rotary |
| <input checked="" type="checkbox"/> Gas | <input type="checkbox"/> Storage | <input type="checkbox"/> Pool Ext. | <input type="checkbox"/> Air Rotary |
| <input type="checkbox"/> OWWO | <input type="checkbox"/> Disposal | <input type="checkbox"/> Wildcat | <input type="checkbox"/> Cable |
| <input type="checkbox"/> Seismic; # of Holes _____ | <input type="checkbox"/> Other _____ | | |
| <input type="checkbox"/> Other _____ | | | |

If OWWO: old well information as follows:

Operator: _____

Well Name: _____

Original Completion Date: _____ Original Total Depth: _____

Directional, Deviated or Horizontal wellbore? Yes No

If Yes, true vertical depth: _____

Bottom Hole Location: _____

KCC DKT #: _____

X WAS: 990' FSL, 990' FEL, NW SESE, 990' FNLL

4 IS: 660' FSL, 440' FEL, approx 110' west of E/2 SE SE

AFFIDAVIT

The undersigned hereby affirms that the drilling, completion and eventual plugging of this well will comply with K.S.A. 55 et. seq.

It is agreed that the following minimum requirements will be met:

1. Notify the appropriate district office **prior** to spudding of well;
2. A copy of the approved notice of intent to drill **shall be** posted on each drilling rig;
3. The minimum amount of surface pipe as specified below **shall be set** by circulating cement to the top; in all cases surface pipe **shall be set** through all unconsolidated materials plus a minimum of 20 feet into the underlying formation.
4. If the well is dry hole, an agreement between the operator and the district office on plug length and placement is necessary **prior to plugging**;
5. The appropriate district office will be notified before well is either plugged or production casing is cemented in;
6. If an ALTERNATE II COMPLETION, production pipe shall be cemented from below any usable water to surface within **120 days** of spud date.
Or pursuant to Appendix "B" - Eastern Kansas surface casing order #133,891-C, which applies to the KCC District 3 area, alternate II cementing must be completed within 30 days of the spud date or the well shall be plugged **in all cases, NOTIFY district office** prior to any cementing.

I hereby certify that the statements made herein are true and to the best of my knowledge and belief.

Date: 6/23/2004 Signature of Operator or Agent: [Signature] Title: PRESIDENT

For KCC Use ONLY

API # 15 - 097-21544-00-00

Conductor pipe required NONE feet

Minimum surface pipe required 260 feet per Alt. 1

Approved by: RJP 6.16.04 / RJP 7.6.04

This authorization expires: 12-16-04
(This authorization void if drilling not started within 6 months of effective date.)

Spud date: _____ Agent: _____

Remember to:

- File Drill Pit Application (form CDP-1) with Intent to Drill;
- File Completion Form ACO-1 within 120 days of spud date;
- File acreage attribution plat according to field proration orders;
- Notify appropriate district office 48 hours prior to workover or re-entry;
- Submit plugging report (CP-4) after plugging is completed;
- Obtain written approval before disposing or injecting salt water.
- If this permit has expired (See: authorized expiration date) please check the box below and return to the address below.

Well Not Drilled - Permit Expired

Signature of Operator or Agent: _____

Date: _____

Mail to: KCC - Conservation Division, 130 S. Market - Room 2078, Wichita, Kansas 67202

30
30
180

IN ALL CASES PLOT THE INTENDED WELL ON THE PLAT BELOW

Plat of acreage attributable to a well in a prorated or spaced field

If the intended well is in a prorated or spaced field, please fully complete this side of the form. If the intended well is in a prorated or spaced field complete the plat below showing that the well will be properly located in relationship to other wells producing from the common source of supply. Please show all the wells and within 1 mile of the boundaries of the proposed acreage attribution unit for gas wells and within 1/2 mile of the boundaries of the proposed acreage attribution unit for oil wells.

API No. 15 - 097-21544-00-00

Operator: Oil Producers, Inc. of Kansas

Lease: EMERSON

Well Number: 1-30

Field: ALFORD

Number of Acres attributable to well: _____

QTR / QTR / QTR of acreage: E/2 - SE - SE

Location of Well: County: KIOWA

660 feet from N / S Line of Section

440 feet from E / W Line of Section

Sec. 30 Twp. 30 S. R. 18 East West

Is Section: Regular or Irregular


If Section Is Irregular, locate well from nearest corner boundary.

Section corner used: NE NW SE SW


PLAT

(Show location of the well and shade attributable acreage for prorated or spaced wells.)

(Show footage to the nearest lease or unit boundary line.)

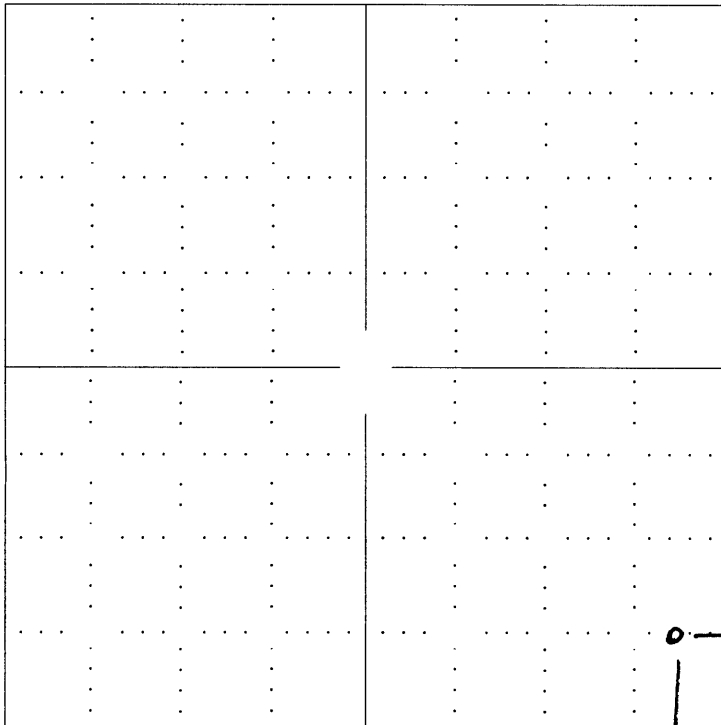

RECEIVED
JUN 24 2004
KCC WICHITA

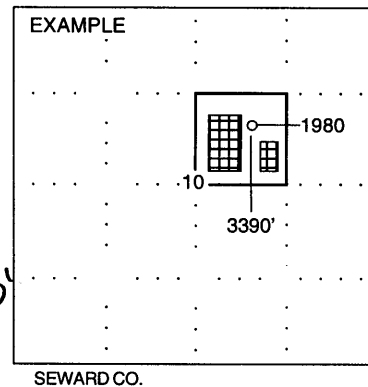

NOTE: In all cases locate the spot of the proposed drilling location

Handwritten annotations: "440'" and "660'" with lines pointing to the grid.

In plotting the proposed location of the well, you must show:

1. The manner in which you are using the depicted plat by identifying section lines, i.e. 1 section, 1 section with 8 surrounding sections, 4 sections, etc.
2. The distance of the proposed drilling location from the section's south / north and east / west.
3. The distance to the nearest lease or unit boundary line.
4. If proposed location is located within a prorated or spaced field a certificate of acreage attribution plat must be attached: (CO-7 for oil wells; CG-8 for gas wells).