

OWWO

For KCC Use: 7-13-04  
Effective Date: 1  
District #  
SGA?  Yes  No

KANSAS CORPORATION COMMISSION  
OIL & GAS CONSERVATION DIVISION

RECEIVED

JUL 06 2004

Form C-1  
December 2002

Form must be Typed  
Form must be Signed  
All blanks must be Filled

NOTICE OF INTENT TO DRILL

Must be approved by KCC five (5) days prior to commencing

KCC WICHITA

Expected Spud Date Upon Approval  
month day year

OPERATOR: License# 31666  
Name: C & R Petroleum Co.  
Address: P.O. Box 404  
City/State/Zip: Spearman Texas 79081  
Contact Person: Curtis F Covington  
Phone: 806-659-3309

CONTRACTOR: License# 33375  
Name: Cheyenne Drilling, Inc.

Well Drilled For:  Gas  Oil  Enh Rec  Storage  Disposal  Seismic; # of Holes  Other  
Well Class:  Infield  Pool Ext.  Wildcat  Other  
Type Equipment:  Mud Rotary  Air Rotary  Cable

If OWWO: old well information as follows:  
Operator: Cities Service Oil Co.  
Well Name: Salley "G" #1 D & A  
Original Completion Date: 2/18/64 Original Total Depth: 6500'

Directional, Deviated or Horizontal wellbore?  Yes  No  
If Yes, true vertical depth:  
Bottom Hole Location:  
KCC DKT #:

Prorated & Spaced Hugobers

Replaces 15-175-00546-00-01 which expired 6/18/04 AFFIDAVIT

The undersigned hereby affirms that the drilling, completion and eventual plugging of this well will comply with K.S.A. 55 et. seq.

It is agreed that the following minimum requirements will be met:

- 1. Notify the appropriate district office prior to spudding of well;
- 2. A copy of the approved notice of intent to drill shall be posted on each drilling rig;
- 3. The minimum amount of surface pipe as specified below shall be set by circulating cement to the top; in all cases surface pipe shall be set through all unconsolidated materials plus a minimum of 20 feet into the underlying formation.
- 4. If the well is dry hole, an agreement between the operator and the district office on plug length and placement is necessary prior to plugging;
- 5. The appropriate district office will be notified before well is either plugged or production casing is cemented in;
- 6. If an ALTERNATE II COMPLETION, production pipe shall be cemented from below any usable water to surface within 120 days of spud date. Or pursuant to Appendix "B" - Eastern Kansas surface casing order #133,891-C, which applies to the KCC District 3 area, alternate II cementing must be completed within 30 days of the spud date or the well shall be plugged. In all cases, NOTIFY district office prior to any cementing.

I hereby certify that the statements made herein are true and to the best of my knowledge and belief.

Date: 7-1-04 Signature of Operator or Agent: [Signature] Title: Curtis F Covington, Owner

For KCC Use ONLY  
API # 15 - 175-00546-00-02  
Conductor pipe required NONE feet  
Minimum surface pipe required 1576' set feet per Alt. 1  
Approved by RJP 7-8-04  
This authorization expires: 1-8-05  
(This authorization void if drilling not started within 6 months of effective date.)  
Spud date: Agent:

Spot SW/4 NE/4 Sec. 30 Twp. 33 S. R. 32  
1980 feet from N / S Line of Section  
1980 feet from E / W Line of Section  
Is SECTION X Regular Irregular?

(Note: Locate well on the Section Plat on reverse side)  
County: Seward  
Lease Name: Salley "G" Well #: 1  
Field Name: Arkalon  
Is this a Prorated / Spaced Field? Unknown  Yes  No  
Target Formation(s): Council Grove  
Nearest Lease or unit boundary: 660'  
Ground Surface Elevation: 2766 feet MSL  
Water well within one-quarter mile:  Yes  No  
Public water supply well within one mile:  Yes  No  
Depth to bottom of fresh water: 440'  
Depth to bottom of usable water: 540'  
Surface Pipe by Alternate:  1  2  
Length of Surface Pipe Planned to be set: 1576' Set  
Length of Conductor Pipe required: NONE  
Projected Total Depth: 3100'  
Formation at Total Depth: Council Grove  
Water Source for Drilling Operations:  
 Well  Farm Pond Other Truck  
DWR Permit #:  
(Note: Apply for Permit with DWR )  
Will Cores be taken?  Yes  No  
If Yes, proposed zone:

Remember to:  
File Drill Pit Application (form CDP-1) with Intent to Drill;  
File Completion Form ACO-1 within 120 days of spud date;  
File acreage attribution plat according to field proration orders;  
Notify appropriate district office 48 hours prior to workover or re-entry;  
Submit plugging report (CP-4) after plugging is completed;  
Obtain written approval before disposing or injecting salt water.  
If this permit has expired (See: authorized expiration date) please check the box below and return to the address below.  
 Well Not Drilled - Permit Expired  
Signature of Operator or Agent:  
Date:

30  
33  
323

**IN ALL CASES PLOT THE INTENDED WELL ON THE PLAT BELOW**

*Plat of acreage attributable to a well in a prorated or spaced field*

**If the intended well is in a prorated or spaced field, please fully complete this side of the form.** If the intended well is in a prorated or spaced field complete the plat below showing that the well will be properly located in relationship to other wells producing from the common source of supply. Please show all the wells and within 1 mile of the boundaries of the proposed acreage attribution unit for gas wells and within 1/2 mile of the boundaries of the proposed acreage attribution unit for oil wells.

API No. 15 - 175-00546  
 Operator: C & R Petroleum Co.  
 Lease: Salley "G"  
 Well Number: 1  
 Field: unknown

Number of Acres attributable to well: 640  
 QTR / QTR / QTR of acreage: \_\_\_\_\_ - SW/4 - NE/4



Location of Well: County: Seward  
1980 feet from  N /  S Line of Section  
1980 feet from  E /  W Line of Section  
 Sec. 30 Twp. 33 S. R. 32  East  West

Is Section:  Regular or  Irregular

**If Section is Irregular, locate well from nearest corner boundary.**  
 Section corner used:  NE  NW  SE  SW

**PLAT**

*(Show location of the well and shade attributable acreage for prorated or spaced wells.)  
 (Show footage to the nearest lease or unit boundary line.)*

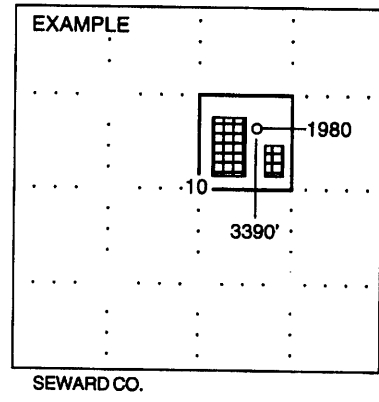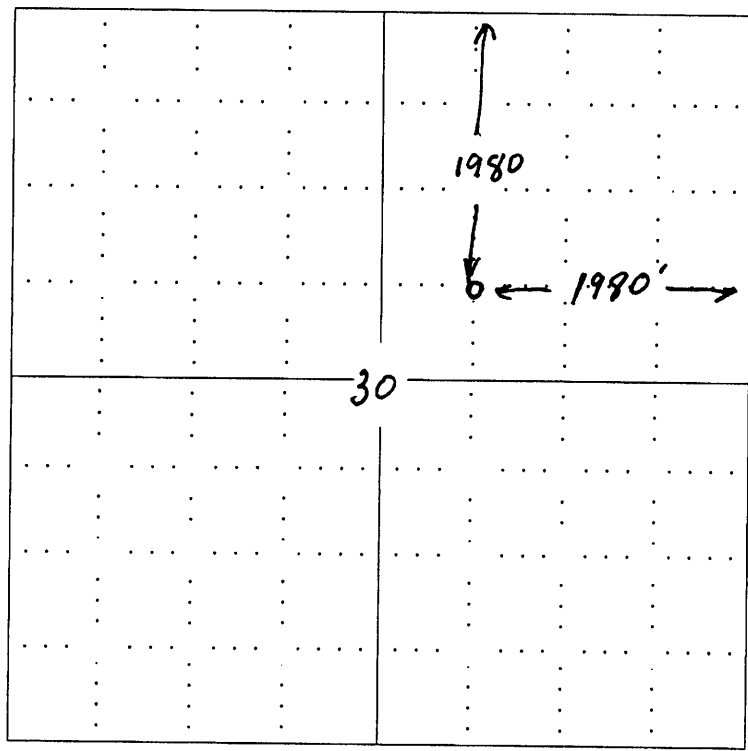

**NOTE: In all cases locate the spot of the proposed drilling location.**

**In plotting the proposed location of the well, you must show:**

1. The manner in which you are using the depicted plat by identifying section lines, i.e. 1 section, 1 section with 8 surrounding sections, 4 sections, etc.
2. The distance of the proposed drilling location from the section's south / north and east / west.
3. The distance to the nearest lease or unit boundary line.
4. If proposed location is located within a prorated or spaced field a certificate of acreage attribution plat must be attached: (CO-7 for oil wells; CG-8 for gas wells).